

ISSUE NOTES (CONTINUED)	ISSUE NOTES (CONTINUED)	ISSUE NOTES
(C1018) IN TABLE A: LIST 2B WAS RATED TO DA. ORIG ISS: 01/29/85 CHANGE CLASS: B DRAFT: WFB ENGR: WFB SUPV: RMB CERTIFIED: 07/02/99 ISSUE: 14	CHANGE TAG H6788= LIST IA WAS RATED STD, LISTS 1B AND F ADDED. NOTE 67 ADDED TO NOTES AND TABLE A LISTS 1 AND 1A. P118= S/L ITEMS 1630,1640,1650 AND 1660 ADDED,FIG C ADDED (PI 6.3, 7.1 AND 7.2 ). ORIG ISS: 01/29/85 CHANGE CLASS: B DRAFT: GLF ENGR: GL SUPV: F CERTIFIED: 02/07/92 ISSUE: 8	ORIG ISS: 01/29/85 NDD NBR: 5D002IH-2 CHANGE CLASS: DRAFT: DJP ENGR: EDH SUPV: JFM VAULT: ISSUE: 1 ----- * DRAWING CONVERTED FROM SEDBS TO MDS COMPUTER SYSTEMS. * * THIS IS A MACHINE COPY OF THE LATEST SEDBS CERTIFIED ISSUE * * AND MAY CONTAIN MINOR DIFFERENCES. THE TABLE OF ASSOCIATED * * DRAWINGS WAS ELIMINATED DURING MIGRATION TO ASSIST THE * * SCRUBBING OF PROPRIETARY INFORMATION. * ----- TABLE AA AND NOTE 14 ADDED. STOCKLIST CHANGES: ITEMS 1530 & 1550 (ED-5D533-10, G18 AND G20) REMOVED. ITEMS 1535,1540 AND 1555 ADDED. ORIG ISS: 01/29/85 NDD NBR: 5D002IH-2 CHANGE CLASS: B DRAFT: DJP ENGR: EDH SUPV: CERTIFIED: 01/28/86 ISSUE: 2
(C1018) TABLE A: LISTS 1E AND 2C WERE ADDED. STOCKLIST: SL ITEM 1416 WAS ADDED. LIST 1E WAS ADDED TO LISTS 1000, 1015, 1018, 1055, 1075, 1080, 1090, 1100, 1110, 1120, 1130, 1160, 1170, 1180, 1191, 1200, 1210, 1220, 1231, 1240, 1250, 1260, 1271, 1280, 1290, 1300, 1310, 1320, 1340, 1350, 1370, 1380, 1390, 1400, 1565, 1570, 1611 AND 1620. ORIG ISS: 01/29/85 CHANGE CLASS: B DRAFT: WFB ENGR: WFB SUPV: RMB CERTIFIED: 07/14/99 ISSUE: 15	CHANGE TAG H7081=IN TA & SL L2A ADDEA.L2 READ STANDARD. CHANGE TAG PI9=ADD BQL 042 SHEET C1. ORIG ISS: 01/29/85 CHANGE CLASS: B DRAFT: SEH ENGR: SEH SUPV: CERTIFIED: 08/05/93 ISSUE: 9	NOTE 15 ADDED. NOTE 54 & 62 CHGD. TBL A LIST 4 RATING CHGD TO 'DA'. SL ITEM 1430 READ '103183885' AND '91B'. TBL AA RMV REF TO 'BAY 1'. TITLE CHGD TO RMV 'TLWS'. DRAWING RATING READ 'PROV'. ORIG ISS: 01/29/85 CHANGE CLASS: D DRAFT: DSL ENGR: PEW SUPV: CERTIFIED: 07/14/86 ISSUE: 3
(H8557) ENGINEERING NOTE: NOTE 54 WAS MODIFIED. TABLE A: LISTS D AND E WERE RATED TO 'DA'. REFERENCE NOTE 500 WAS ADDED TO LIST 2C. ORIG ISS: 01/29/85 CHANGE CLASS: ME DRAFT: RAR ENGR: RAR SUPV: RMB CERTIFIED: 01/26/00 ISSUE: 16	CHANGE TAG PI9.1=ITEM 1000 PI WAS 843062043, GRAPHICS CHANGED ACCORDINGLY. NOTE 62 ED5D522-34 WAS ED5D522-32. SL ITEM 1610 LINED OUT, 1611 ADDED. CHANGE TAG H7281=IN TABLE A & STOCKLIST GROUPS 2B,1C ADDED. NOTE 54 GROUP 2B ADDED. SL ITEMS 1414,1565,1595,1611 ADDED. GROUP 1B,2A,C RATING WAS STD. ORIG ISS: 01/29/85 CHANGE CLASS: B DRAFT: JRK ENGR: JRK SUPV: CERTIFIED: 10/07/94 ISSUE: 10	LIST 3 & 5 RATING CHANGED TO 'DA'. NOTE 63 ADDED. ORIG ISS: 01/29/85 CHANGE CLASS: B DRAFT: DSL ENGR: PEW SUPV: CERTIFIED: 08/08/86 ISSUE: 4
(H09158) IN TABLE A : LIST 2C RATED DA. TBL A, LIST F, CHGD DESC ... ADDITION TO LIST 1 OR 1A IN ... TO READ ... ADDITION TO LIST 1 OR 1A OR 1E ... ORIG ISS: 01/29/85 CHANGE CLASS: B DRAFT: PWV ENGR: PWV SUPV: DML CERTIFIED: 10/20/00 ISSUE: 17	CHG TAG H7589=IN TABLE A AND STOCKLIST LISTS 500 THRU 505 ADDED. NOTES 151 & 152 ADDED. ORIG ISS: 01/29/85 CHANGE CLASS: B DRAFT: JRK ENGR: JRK SUPV: CERTIFIED: 09/08/95 ISSUE: 11	TABLE A, LIST C; NOTE 64; SL ITEMS 1425 AND 1600 ADDED. SL ITEM 1030, REF TO NOTE 'S' ADDED. NOTE 53 MODIFIED. GRAPHICS CHGD ACCORD. ORIG ISS: 01/29/85 CHANGE CLASS: M DRAFT: DSL ENGR: PEW SUPV: CERTIFIED: 05/17/88 ISSUE: 5
(V00104) TABLE A: LISTS 1E, 500, THRU 503, 505 AND F ARE RATED "DA", AS A RESULT OF IMR (727516) ALL LIST ARE RATED "DA" AFTER THIS ISSUE. ORIG ISS: 01/29/85 CHANGE CLASS: B DRAFT: WFB ENGR: WFB SUPV: DML CERTIFIED: 03/09/01 ISSUE: 18	CHANGE TAG H7868=FIG. C ADDED. FIG. B LINED OUT. TITLE BOX & NOTES 51,56,57 CHANGED. GRAPHICS CHANGED ACCORDINGLY. ORIG ISS: 01/29/85 CHANGE CLASS: B DRAFT: JRK ENGR: JRK SUPV: CERTIFIED: 09/05/96 ISSUE: 12	SL ITEM 1490, REF TO LIST 2 ADDED. GRAPHICS CHANGED ACCORDINGLY. ED5D092-30,G2 ON SHT C1 READ LIST 2A. UPPER AND LOWER DOOR FRAME ADDED TO SHT C1. SL ITEMS 1020 AND 1070 LINED OUT, ITEMS 1011 AND 1071 ADDED, 'S' SYM REMOVED FROM ITEM 1030, ITEMS 1370,1380 AND 1400 QTY READ 8. ORIG ISS: 01/29/85 CHANGE CLASS: M DRAFT: PKK ENGR: GLF SUPV: CERTIFIED: 01/11/90 ISSUE: 6
	CHANGE TAG H8170=IN TABLE A, ADD LIST 1D AND GRAPHIC FIG.2 TO SHEET C2. STOCKLIST ITEN 1018 S ADDED. TABLE A, LIST 504 IS DA. CHANGE ALL GRAPHIC SHEET ACCORDINGLY TO PRO-E. STOCKLIST ITEM 5040 IS DA. ORIG ISS: 01/29/85 NDD NBR: NDD5D002NW-12 CHANGE CLASS: B DRAFT: WFB ENGR: WFB SUPV: RGM CERTIFIED: 06/12/97 ISSUE: 13	CHANGE TAG H6697= LISTS 1,A AND B WERE RATED STANDARD. LISTS 1A, D AND E ADDED. NOTES 16, 65 AND 66 ADDED. CHANGE TAG PI7= ON SHEET C1 TELEPHONE PANEL LIST 1 OR 1A READ LIST 2 ONLY, SECT A-A ADDED. MFG NOTE 12 LINED OUT. STOCKLIST ITEM 1150 LINED OUT, ITEM 1490 READ 25. (PI 6.1 & 6.2). ORIG ISS: 01/29/85 CHANGE CLASS: B DRAFT: PKK ENGR: GLF SUPV: CERTIFIED: 04/08/91 ISSUE: 7

SHEET INDEX								
SHT NBR	A1 THRU A3							ISSUE 18
ISSUE								
SHT NBR	D1 THRU D4							ISSUE 18
ISSUE								
SHT NBR	B1							
ISSUE	13							
SHT NBR	C1	C2	C3	C4	C5	C6	C7	
ISSUE	13	13	13	13	13	13	13	
SHT NBR								
ISSUE								
SHT NBR								
ISSUE								
TABLE OF CONTENTS	
DESCRIPTION	SHT
SHEET INDEX	A1
ISSUE NOTES	A1
ENGINEERING-NOTES	A2
TABLE A	A2
B SECTION GRAPHICS	B1
C SECTION GRAPHICS	C1
MANUFACTURING NOTES	D1
STOCKLIST	D1
MISCELLANEOUS TABLES	D3

COPYRIGHT © 2001 LUCENT TECHNOLOGIES ALL RIGHTS RESERVED	
BT13	
5ESS SWITCHING EQUIPMENT SPECIFICATION FOR VIDEO DISPLAY CABINET MCC/STLWS	
DWG SIZE C2	ISSUE 18
LUCENT TECHNOLOGIES INC	J5D002B-1
SHEET A1 OF 15	

TABLE A-FEATURES											
EQUIPMENT		EQUIPMENT OR CIRCUIT DATA						SD EQUIVALENT			
DESCRIPTION	REF NOTE	RAT-ING	LIST OR GROUP	QTY	EQUIPMENT OR CIRCUIT	L/G OR FIG	WRG	APP	SCHEMATIC	FIG	OPT
FRAMEWORK, EQUIPMENT AND ASSEMBLY FOR A VIDEO DISPLAY CABINET FOR USE IN A MASTER CONTROL CENTER (MCC) OR SUPPLEMENTARY TRUNK LINE WORK STATION (STLWS). (SEE NOTE 53). (SEE LIST 1A). DA EFF:12/31/91	67	DA	1	1	SD5D114-01	1					
FRAMEWORK, EQUIPMENT AND ASSEMBLY FOR A VIDEO DISPLAY CABINET FOR USE IN A MASTER CONTROL CENTER (MCC) OR SUPPLEMENTARY TRUNK LINE WORK STATION (STLWS). DA EFF:02/07/92 FE:J5D002B-1,L1B	53 67	DA	1A	1	SD5D114-01	1					
FRAMEWORK, EQUIPMENT AND ASSY FOR A VIDEO DISPLAY CABINET FOR USE IN A MASTER CONTROL CENTER (MCC) OR SUPPLEMENTARY TRUNK LINE WORK STATION (STLWS). DA EFF:10/07/94 FE:J5D002B-1,L1C	53	DA	1B	1	SD5D114-01	1					
FRAMEWORK, EQUIPMENT AND ASSY FOR A VIDEO DISPLAY CABINET FOR USE IN A MASTER CONTROL CENTER (MCC) OR SUPPLEMENTARY TRUNK LINE WORK STATION (STLWS). DA EFF:06/12/97 FE:J5D002B-1,L1D	53	DA	1C	1	SD5D114-01	1					
FRAMEWORK, EQUIPMENT AND ASSY FOR A VIDEO DISPLAY CABINET FOR USE IN A MASTER CONTROL CENTER (MCC) OR SUPPLEMENTARY TRUNK LINE WORK STATION (STLWS) E/W SHORT DOORS. REPL:J5D002B-1,L1C DA EFF:07/02/99 FE:J5D002B-1,L1E	53	DA	1D	1	SD5D114-01	1					
FRAMEWORK, EQUIPMENT AND ASSY FOR A VIDEO DISPLAY CABINET FOR USE IN A MASTER CONTROL CENTER (MCC) OR SUPPLEMENTARY TRUNK LINE WORK STATION (STLWS). REPL:J5D002B-1,L1D DA EFF:03/09/01 FE/RA:NONE	53	DA	1E	1	SD5D114-01	1					
EQUIPMENT, WIRING AND ASSEMBLY REQUIRED IN ADDITION TO LIST 1, 1A OR 1B TO PROVIDE A TEST ACCESS UNIT. (SEE NOTE 54). DA EFF:08/05/93 FE:J5C002B-1,L2A		DA	2	1	SD5D114-01 ED5D092-30	2 2					
EQUIPMENT, WIRING AND ASSEMBLY REQUIRED IN ADDITION TO LIST 1, 1A OR 1B TO PROVIDE A TEST ACCESS UNIT. PROVIDES FOR THE NEW EAY1 CIRCUIT PACK. REPL:J5D002B-1,L2 DA EFF:10/07/94 FE:J5D002B-1,L2B	54	DA	2A	1	SD5D114-01 ED5D092-30	2 2A					
EQUIPMENT, WIRING AND ASSEMBLY REQUIRED IN ADDITION TO LIST 1, 1A OR 1B TO PROVIDE A TEST ACCESS UNIT. PROVIDES FOR THE NEW EAY CIRCUIT PACK. REPL:J5D002B-1,L2A DA EFF:07/02/99 FE:J5D002B-1,L2C	54	DA	2B	1	SD5D114-01 ED5D092-30	2 2B					
EQUIPMENT, WIRING AND ASSEMBLY REQUIRED IN ADDITION TO LIST 1E TO PROVIDE A TEST ACCESS UNIT. PROVIDES FOR THE NEW EAY CIRCUIT PACK. REPL:J5D002B-1,L2B DA EFF:01/26/00 FE/RA:NONE	54 500	DA	2C	1	SD5D114-01	2					
EQUIPMENT, WIRING AND ASSEMBLY REQUIRED IN ADDITION TO LIST 1 TO PROVIDE A MULTI LINE TELEPHONE SET. (SEE NOTE 54). DA EFF:12/01/90		DA	3	1	SD5D114-01	3					

TABLE-A CONTINUED

J5D002B-1

ENGINEERING NOTES

51. INFORMATION FURNISHED PER THIS DRAWING IS IN ACCORDANCE WITH LUCENT TECHNOLOGIES PRACTICES-NONE.
52. THIS DOCUMENT CONTAINS COMPLETE ENGINEERING INFORMATION FOR THE SUBJECT EQUIPMENT. JOB INFORMATION SHALL BE RECORDED BY LIST OR GROUP.
53. LINE ENGINEERING MUST SPECIFY A VIDEO DISPLAY CABINET WHEN FURNISHING A MASTER CONTROL CENTER. THE VIDEO DISPLAY CABINET IS OPTIONAL FOR A SUPPLEMENTARY TRUNK LINE WORK STATION.
54. LISTS 2,2A,2B,2C AND 3 ARE OPTIONAL FOR A SUPPLEMENTARY TRUNK LINE WORK STATION BUT ARE REQUIRED FOR A MASTER CONTROL CENTER.
55. LISTS 4 AND 5 ARE MUTUALLY EXCLUSIVE.
56. REFER TO LUCENT TECHNOLOGIES PRACTICES-518-450-106 FOR TELEPHONE SET DETAILS.
57. TO ORDER AND CONNECT ADDITIONAL 'COM KEY' 416 KEY TELEPHONE SETS REFER TO LUCENT TECHNOLOGIES PRACTICES-518-450-106 AND TOP-518-450-107.
58. JOB REQUIREMENTS CAN SPECIFY UP TO SIX STLWS, WHICH WILL REQUIRE ADDITIONAL CABLING PER ED-5D500-11.
59. UNASSIGNED.
60. THIS DRAWING REPLACES PART OF J5D002A-1. REFER TO J5D002A-2 FOR THE PRINTER CABINET.
61. THE VIDEO DISPLAY TERMINAL FOR THE MASTER CONTROL CENTER IS ORDERED PER THE 378 JOB SPEC AND J1C176A-1.
62. THE VIDEO DISPLAY TERMINAL FOR THE SUPPLEMENTARY TRUNK LINE WORK STATION IS ORDERED PER THE 385 JOB SPEC AND ED-5D522-34.
63. THE 2981A01-50 TEL SET PER LIST 5 IS MANUFACTURE DISCONTINUED. THIS TEL SET IS AVAILABLE AS REFURBISHED ('R') STOCK ONLY. A TEL SET SUCH AS MERLIN TM OR EQUIVALENT MAY BE USED AS THE PRIMARY TEL SET PER CUSTOMER OPTION.
64. IN TABLE A, DESCRIPTION FIELD INFORMATION ENCLOSED IN < > IS FOR REPORT PURPOSES ONLY.
65. THE CABINET DESIGNATION LABELS FOR THE STLWS ARE TO BE JOB ENGINEERED USING THE GROUPS SHOWN IN TABLE AB.
66. DOLLAR SIGNS(&) IN FRONT OF AND BEHIND WORDS, SENTENCES, PARAGRAPHS AND/OR CHARACTERS INDICATE HORIZONTALLY LINE OUT INFORMATION.
67. EXISTING LIST 1 OR LIST 1A J5D002B-1 VIDEO CABINETS MUST BE MODIFIED, WHEN THE LARGER KS23554 L5 COLORSCAN MONITOR IS TO BE LOCATED IN THIS CABINET. THE CABINET MUST BE REMOVED FROM THE LINE UP, DISASSEMBLED AND REASSEMBLED USING NEW PIECE PARTS PROVIDED BY LIST F AND EXISTING ATTACHING HARDWARE REMOVED IN THE DISASSEMBLE OPERATION.
151. THIS LIST IS NOT GENERALLY AVAILABLE, BUT IS INTENDED TO SUPPORT FACTORY OFFLOADS FROM NETWORK SYSTEMS INTERNATIONAL (NSI)
152. IN TABLE A DESCRIPTIONS, INFORMATION WITHIN \*\* \*\* INDICATES THE FUNCTIONAL OBJECT ASSIGNED TO THAT ITEM.
500. THIS LIST MAY BE SPECIFIED AS A MAIN OR SUPPLEMENTAL ITEM.

COPYRIGHT © 2001 LUCENT TECHNOLOGIES  
ALL RIGHTS RESERVED

5ESS SWITCHING EQUIPMENT  
SPECIFICATION FOR  
VIDEO DISPLAY CABINET  
MCC/STLWS

BT13

DWG SIZE C2 ISSUE 18

LUCENT TECHNOLOGIES INC J5D002B-1

SHEET A2 OF 15

TABLE A-FEATURES (CONTINUED)												
EQUIPMENT		EQUIPMENT OR CIRCUIT DATA							SD EQUIVALENT			
DESCRIPTION	REF NOTE	RAT-ING	LIST OR GROUP	QTY	EQUIPMENT OR CIRCUIT	L/G OR FIG	WRG	APP	SCHEMATIC	FIG	OPT	
EQPT AND ASSEMBLY REQ'D IN ADDITION TO LIST 3 TO PROVIDE 2983A01-50 TELEPHONE SET. (SEE NOTE 55 AND 56). DA EFF:01/01/86		DA	4	1	SD5D114-01	4						
EQUIPMENT AND ASSEMBLY REQUIRED IN ADDITION TO LIST 3 TO PROVIDE 2981A01-50 TELEPHONE SET. (SEE NOTE 55 AND 57). DA EFF:12/01/91		DA	5	1	SD5D114-01	5						
**MCCABV** EQUIPMENT FOR ONE VIDEO DISPLAY CABINET, FOR USE IN A MASTER CONTROL CENTER (MCC) OR SUPPLEMENTARY TRUNK LINE WORK STATION (STLWS). REPL:NONE DA EFF:03/09/01 FE/RA:NONE	151 152	DA	500									
**TELJKMT** PROVIDES ONE TELEPHONE JACK, #MT331. REPL:NONE DA EFF:03/09/01 FE/RA:NONE	151 152	DA	501									
**DOORUP** DOOR FRAME ASSEMBLY, UPPER. REPL:NONE DA EFF:03/09/01 FE/RA:NONE	151 152	DA	502									
**DORFRASSY** DOOR FRAME ASSEMBLY. REPL:NONE DA EFF:03/09/01 FE/RA:NONE	151 152	DA	503									
**DORASSY** DOOR ASSEMBLY. DA EFF:06/12/97 FE/RA:NONE	151 152	DA	504									
**DOORLOW** DOOR FRAME ASSEMBLY, LOWER. REPL:NONE DA EFF:03/09/01 FE/RA:NONE	151 152	DA	505									
EQUIPMENT REQUIRED IN ADDITION TO LIST 1 WHEN THIS CABINET IS USED IN A MASTER CONTROL CENTER (MCC). (SEE LIST D). DA EFF:12/31/92		DA	A									
EQUIPMENT REQUIRED IN ADDITION TO LIST 1 WHEN THIS CABINET IS USED IN A SUPPLEMENTARY TRUNK LINE WORK STATION (STLWS). (SEE LIST E). DA EFF:03/31/92		DA	B									
EQUIPMENT AND WIRING ALWAYS REQUIRED IN ADDITION TO LIST 2 GENERIC 5E1, 5E1 OR LATER. (SEE NOTE 64). <5E1> <5E1 OR LATER> DA EFF:10/07/94 FE/RA:NONE		DA	C	1	ED5D092-30	A						
EQUIPMENT REQUIRED IN ADDITION TO LIST 1A OR 1B WHEN THIS CABINET IS USED IN A MASTER CONTROL CENTER (MCC). DA EFF:02/07/00 FE/RA:NONE		DA	D	2	ED5D695-10	1494						
EQUIPMENT REQUIRED IN ADDITION TO LIST 1A OR 1B WHEN THIS CABINET IS USED IN A SUPPLEMENTARY TRUNK LINE WORK STATION (STLWS). DA EFF:02/07/00 FE/RA:NONE	65	DA	E	2	ED5D695-10	( )						

TABLE-A CONTINUED

TABLE A-FEATURES (CONTINUED)												
EQUIPMENT		EQUIPMENT OR CIRCUIT DATA							SD EQUIVALENT			
DESCRIPTION	REF NOTE	RAT-ING	LIST OR GROUP	QTY	EQUIPMENT OR CIRCUIT	L/G OR FIG	WRG	APP	SCHEMATIC	FIG	OPT	
EQUIPMENT REQUIRED IN ADDITION TO LIST 1 OR 1A OR 1E IN EXISTING OFFICES FOR A VIDEO CABINET FOR USE IN A MASTER CONTROL CENTER (MCC) OR SUPPLEMENTARY TRUNK LINE WORK STATION (STLWS), WHEN THE LARGER KS23554 L5 COLORSKAN MONITOR IS TO BE LOCATED IN THIS CABINET. DA EFF:03/09/01 FE/RA:NONE	67	DA	F									
END OF TABLE-A												

COPYRIGHT © 2001 LUCENT TECHNOLOGIES  
ALL RIGHTS RESERVED

BT13

5ESS SWITCHING EQUIPMENT  
SPECIFICATION FOR  
VIDEO DISPLAY CABINET  
MCC/STLWS

DWG SIZE C2 ISSUE 18


J5D002B-1

LUCENT TECHNOLOGIES INC J5D002B-1


SHEET A3 OF 15

PRINTED IN U.S.A.

D

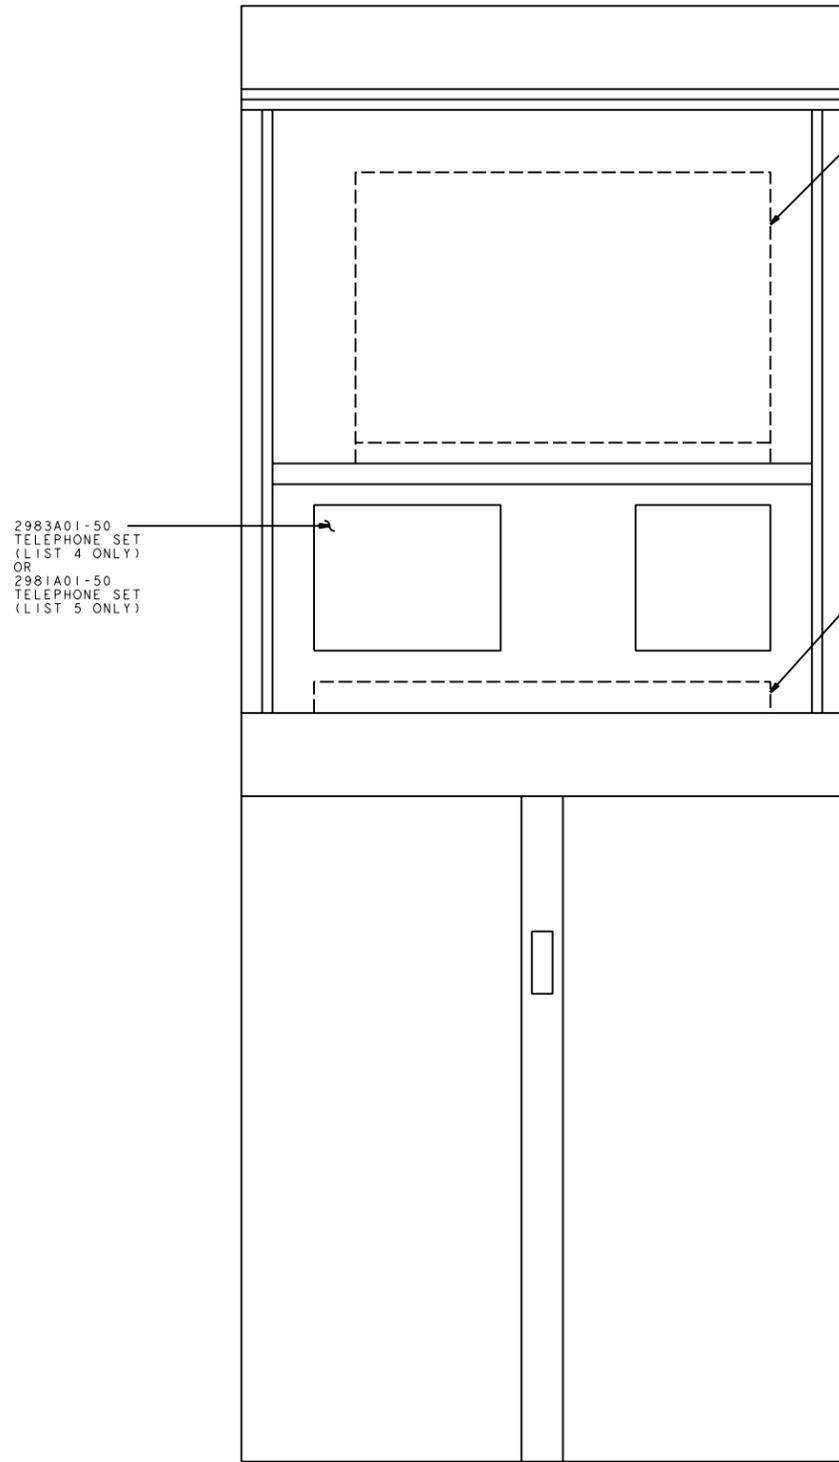

FRONT VIEW

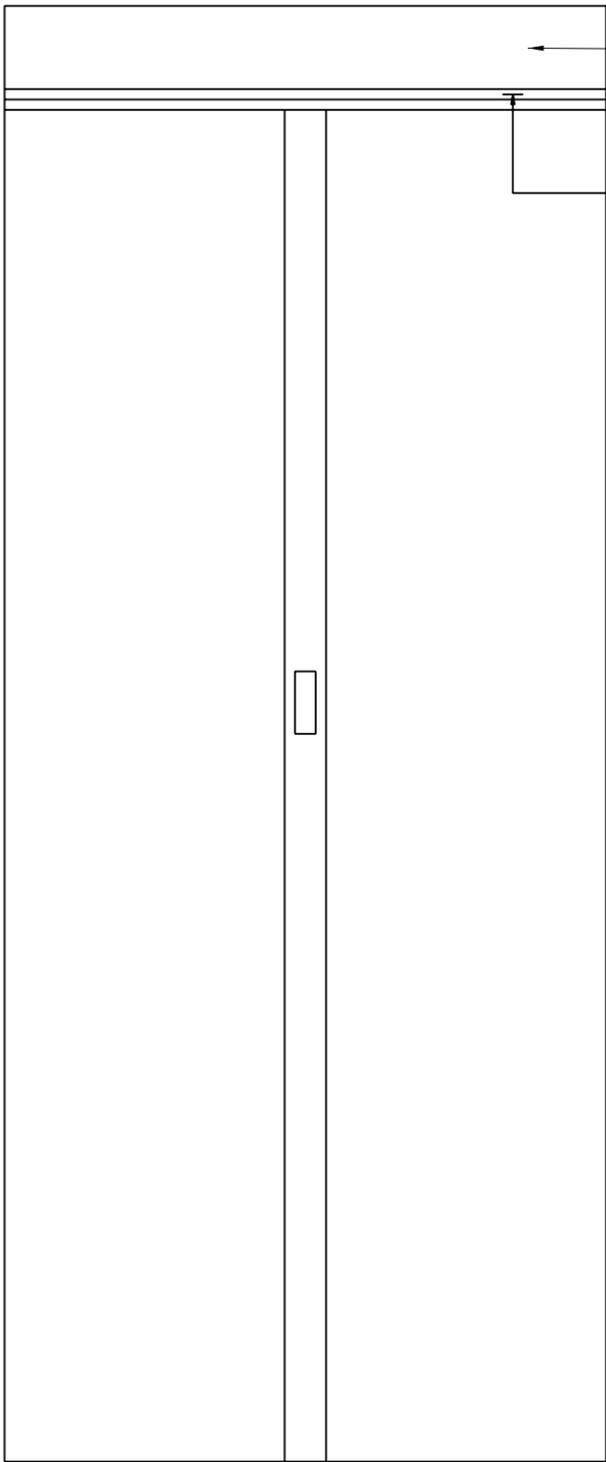

REAR VIEW

FIG. 1

PROJ-EGEDFORM.FRM-FEB-96

J5D002B-1

FOR PROPRIETARY NOTICE SEE SHEET A1		
VIDEO DISPLAY CABINET MCC/STLWS	THIRD ANGLE PROJN 	
(P) DWG SIZE C2	ISSUE 13	SHEET NO. B1
LUCENT TECHNOLOGIES	J5D002B-1	MODEL NAME

STAMP J5D002B-1  
(REAR ONLY)

STAMP SD-5D114-01 (REAR ONLY)

846860773 (LIST 1B)  
843084757 BACK PANEL (LIST 1 OR 1A)

843084740 SIDE PANEL ASSEMBLY  
(RIGHT) (LIST 1 OR 1A)  
846860765 SIDE PANEL ASSEMBLY  
(RIGHT) (LIST 1B)

846860757 (LIST 1B)  
843082157 (LIST 1 & 1A)  
SIDE PANEL  
ASSEMBLY (LEFT)

843082207 SHELF ASSEMBLY

845080969  
TELEPHONE PANEL  
ASSEMBLY E/W  
845080977  
BRACKET ASSEMBLY  
(LIST 5 ONLY)

843082199 MOUNTING BRACKET

846860781 (LIST 1B)  
845080969  
TELEPHONE  
PANEL  
(LIST 1 OR 1A)

843082009 TELEPHONE PANEL ASSEMBLY (LIST 4 ONLY)

843082892 COVER ASSEMBLY (LIST 1 ONLY)

ED-5D092-30,G2 TEST ACCESS UNIT (LIST 2,C ONLY)  
(MOUNT AT EQL 042)

LABEL 844660738 (LIST 2 ONLY)

SEE DETAIL B

843082249  
SLIDE MTG BRKT  
ASSEMBLY (LEFT)


843081977 KEYBOARD SHELF ASSEMBLY

843082280  
ANGLE

843081993 KEYBOARD DRAWER ASSEMBLY

843081944 SHELF ASSEMBLY

843082066  
SIDE PANEL  
ASSEMBLY

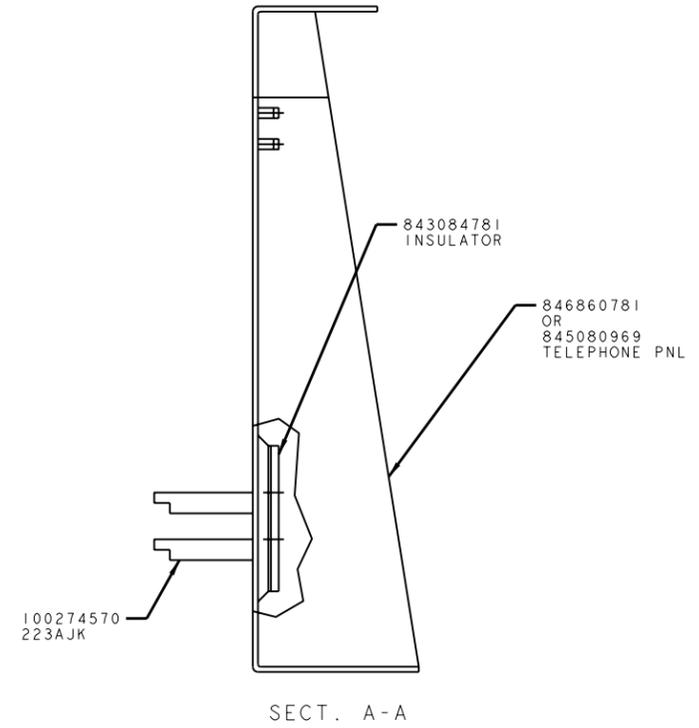

FRONT VIEW  
( SHOWN WITHOUT DOORS )

PROJ-EGEDFORM.FRM-FEB 96

J5D002B-1

FOR PROPRIETARY NOTICE SEE SHEET A1			
VIDEO DISPLAY CABINET MCC/STLWS		THIRD ANGLE PROJN	
DWG SIZE C2		ISSUE 13	
LUCENT TECHNOLOGIES		SHEET NO. C1	
MODEL NAME		J5D002B-1	

845310283 UPPER DOOR FRAME ASSEMBLY  
~~843082215 FRAME BEZEL ASSEMBLY~~  
 E/W  
 843077900 BEZEL AND  
 TWO 843077942 BRACKET  
 LIST I  
 846364842 UPPER DOOR  
 FRAME ASSEMBLY  
 E/W ED5D694-30.G2 BEZEL  
 LIST IA OR IB

845310283 UPPER DOOR FRAME ASSEMBLY  
 LIST I  
 846364842 UPPER DOOR  
 FRAME ASSEMBLY  
 LIST IA OR IB  
 843077900 BEZEL E/W  
 TWO 843077942 BRACKET AND  
 TWO 843084104 PANEL  
 LIST I  
 ED5D694-30.G2 BEZEL  
 LIST IA OR IB

846940252 FRAME ASSEMBLY

~~843077942 DOOR FRAME ASSEMBLY~~

~~843079815 DOOR ASSEMBLY (LI)~~  
 845622976 DOOR ASSEMBLY (LIA)

843082082 DOOR FRAME ASSEMBLY

SEE DETAIL A

843062100 FRAME SUPPORT ASSEMBLY

843082116 DOOR ASSEMBLY



845310291 LOWER DOOR FRAME ASSEMBLY

RIGHT SIDE VIEW

PROJ-EGEDFORM.FRM-FEB 96

J5D002B-1

FOR PROPRIETARY NOTICE SEE SHEET A1		
VIDEO DISPLAY CABINET MCC/STLWS	THIRD ANGLE PROJ 	
(P) DWG SIZE C2	ISSUE 13	SHEET NO. C2
LUCENT TECHNOLOGIES	J5D002B-1	MODEL NAME

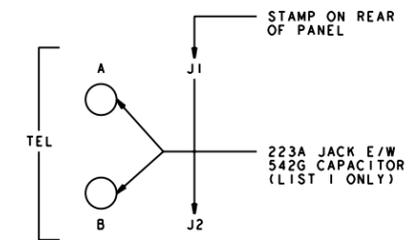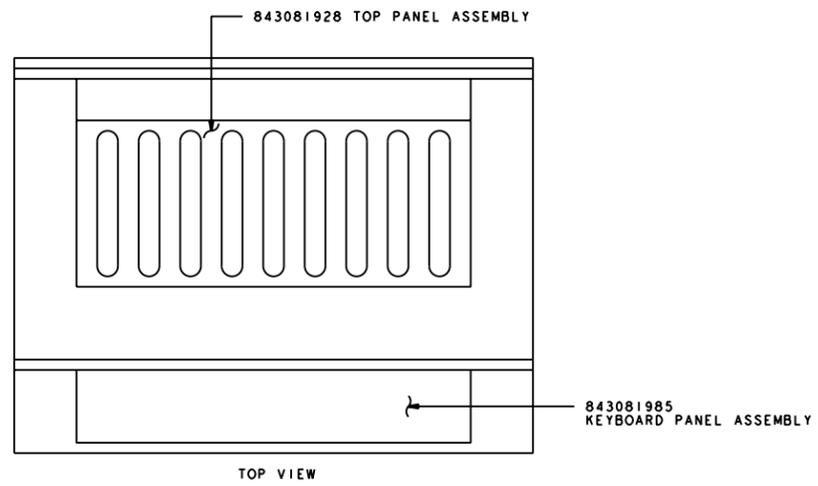

DETAIL B  
SHOP STAMPING (LIST 1 ONLY)

PROJ - EGEDFORM, FRM - FEB 96

J5D002B-1

FOR PROPRIETARY NOTICE SEE SHEET A1		
VIDEO DISPLAY CABINET MCC/STLWS	THIRD ANGLE PROJ 	
(P) DWG SIZE C2	ISSUE 13	SHEET NO. C3
LUCENT TECHNOLOGIES	J5D002B-1	MODEL NAME



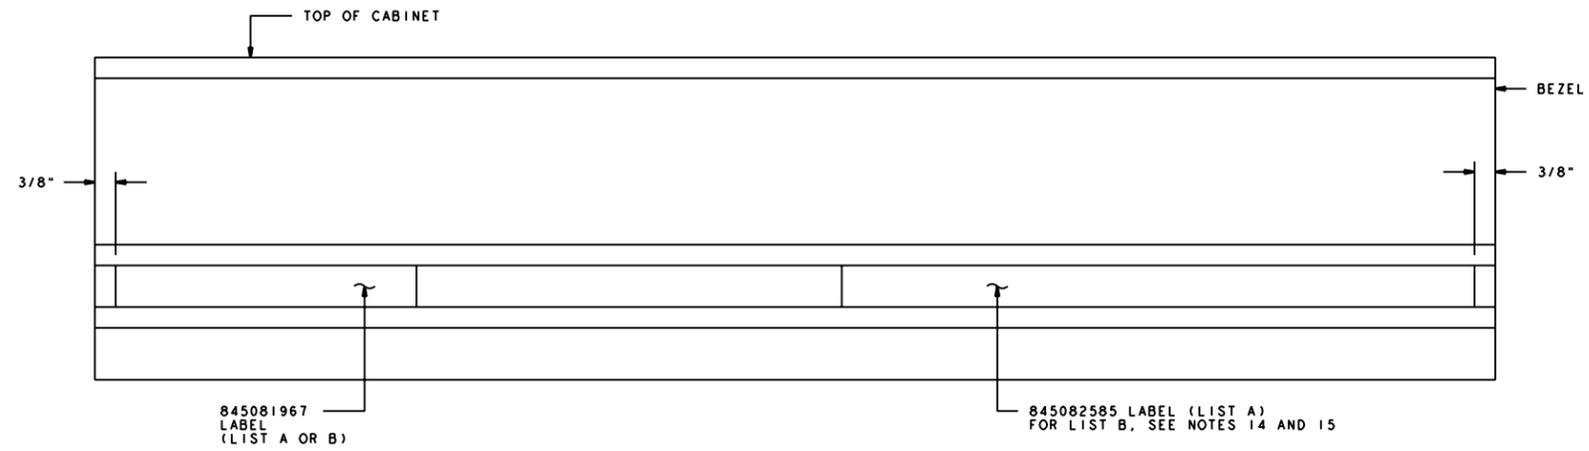


FIG. A  
 LOCATION OF CABINET DESIGNATION LABELS  
 ( TYPICAL FOR FRONT AND REAR )

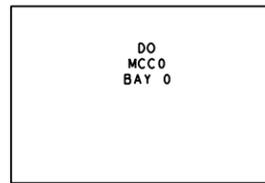

WHEN THIS CABINET  
 IS USED IN AN MCC

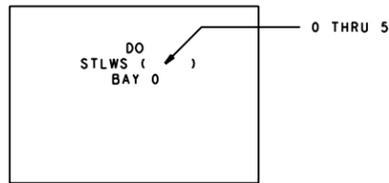

WHEN THIS CABINET  
 IS USED IN AN STLWS

DETAIL A  
 SHOP STAMPING

PROJ-EGEDFORM.FRM-FEB-96

J5D002B-1

FOR PROPRIETARY NOTICE SEE SHEET A1		
VIDEO DISPLAY CABINET MCC/STLWS		THIRD ANGLE PROJ 
DWG SIZE C2	ISSUE 13	SHEET NO. C4
LUCENT TECHNOLOGIES	J5D002B-1	MODEL NAME

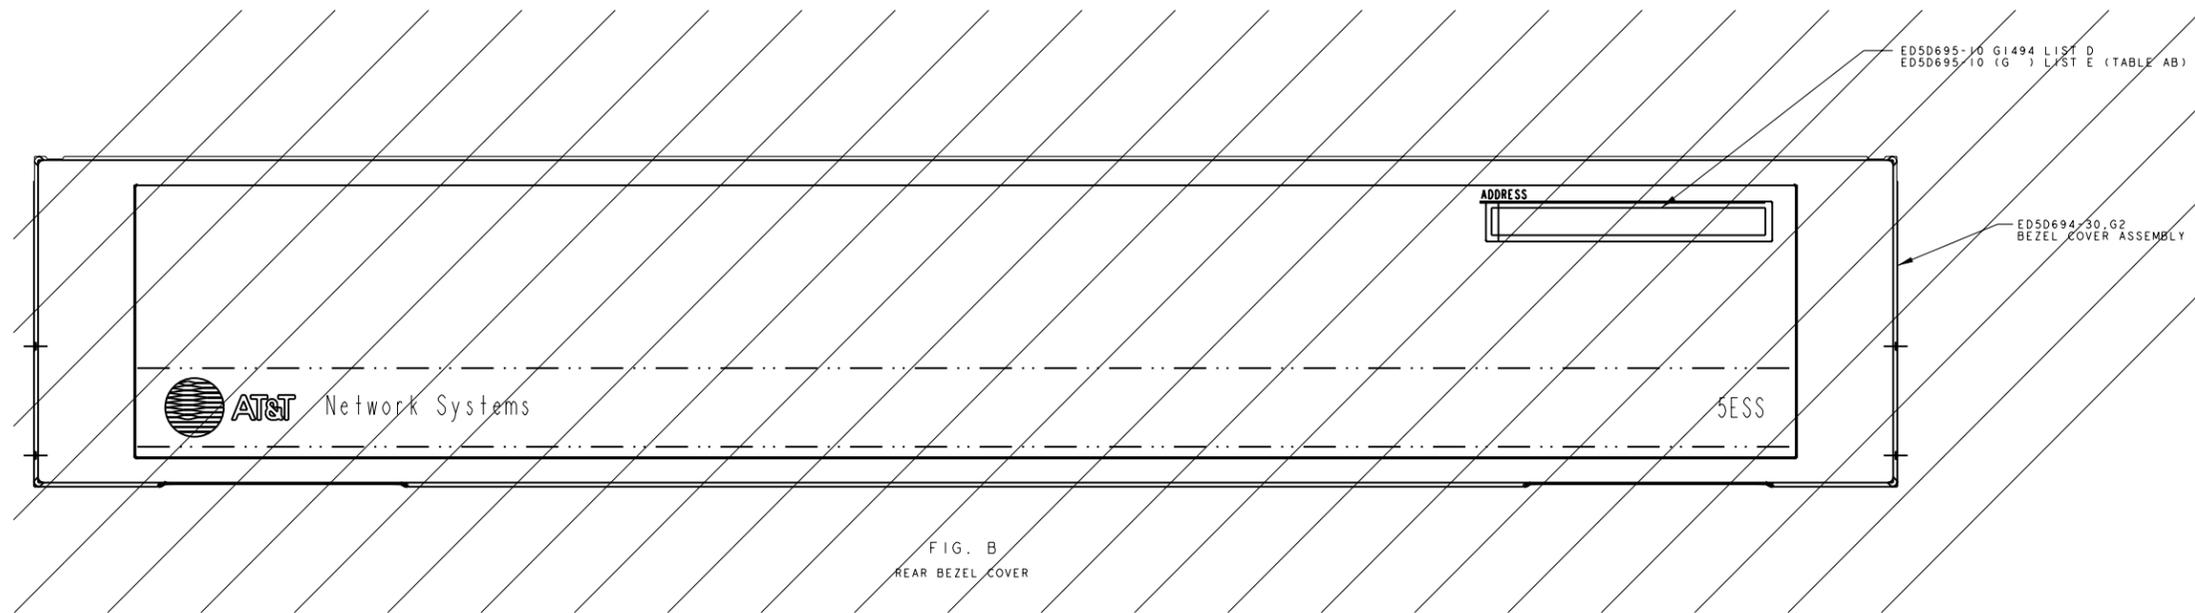


FIG. B  
REAR BEZEL COVER


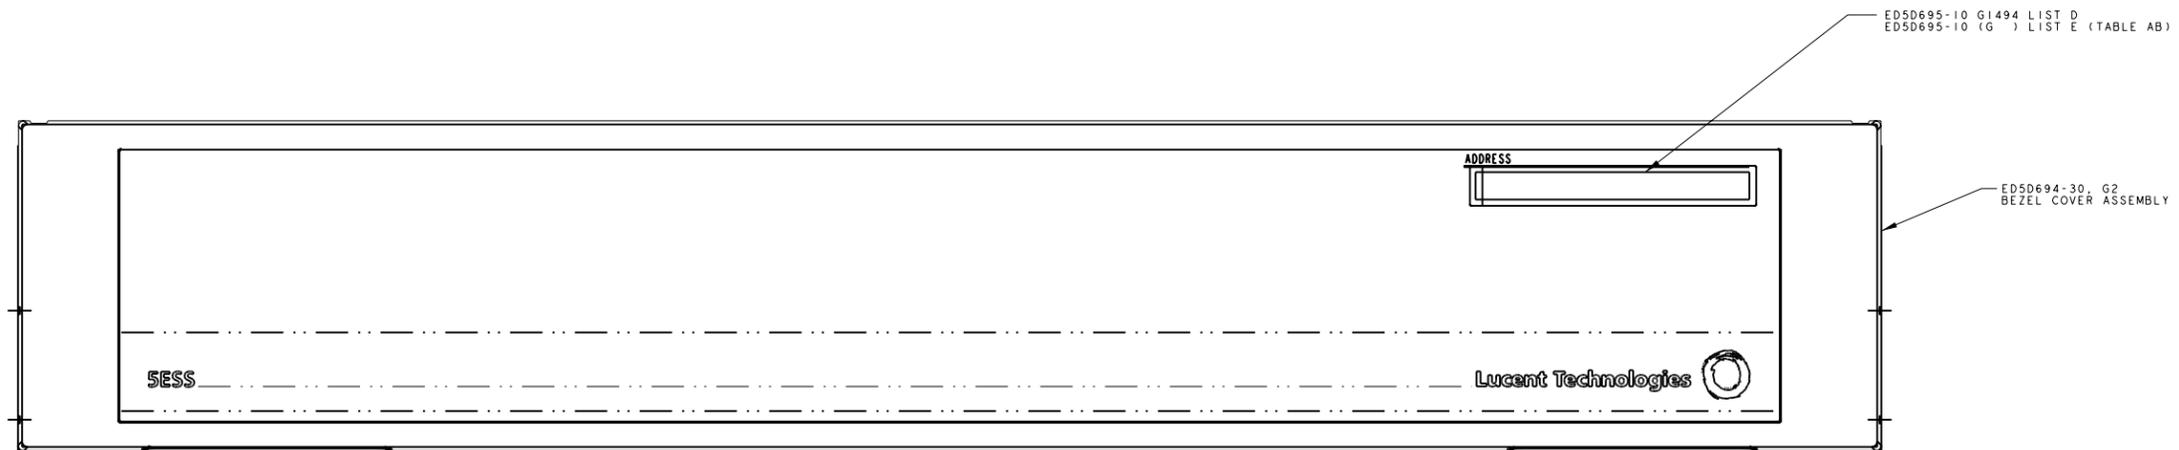


FIG. C  
REAR BEZEL COVER

PROJ-EGEDFORM.FRM-FEB-96

J5D002B-1

FOR PROPRIETARY NOTICE SEE SHEET A1			
VIDEO DISPLAY CABINET MCC/STLWS		THIRD ANGLE PROJ 	
(P) DWG SIZE C2		ISSUE 13	
LUCENT TECHNOLOGIES	J5D002B-1	SHEET NO. C5	
MODEL NAME			

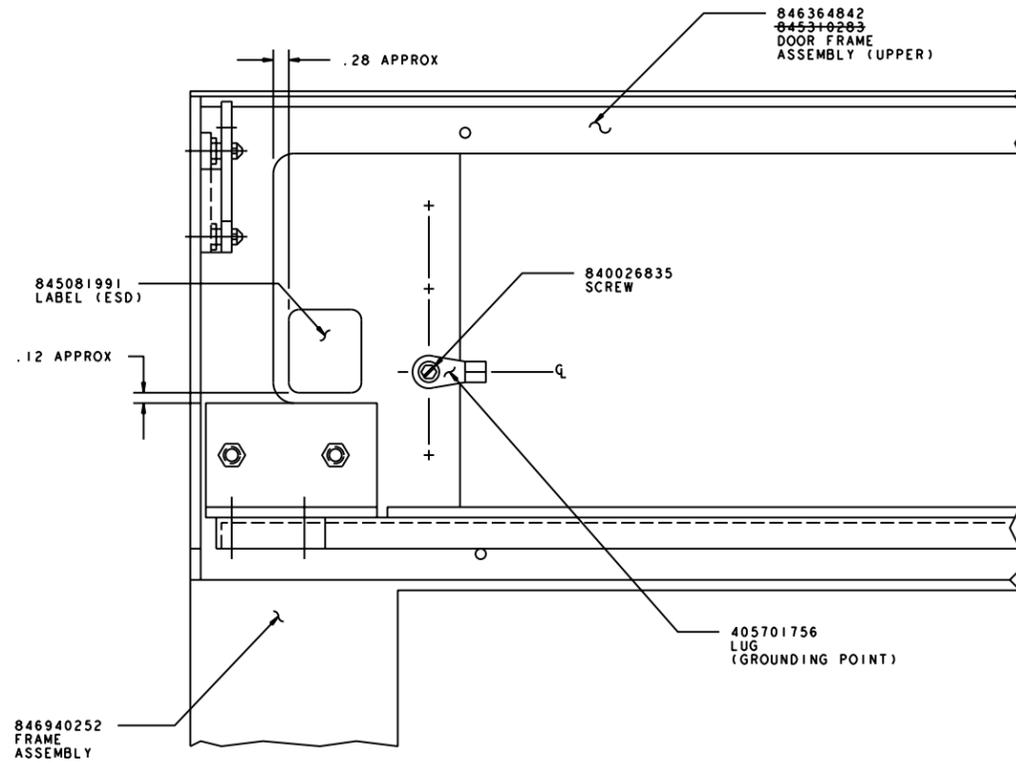

WIRING AND EQUIPMENT SIDES  
(BEZEL REMOVED FOR CLARITY)  
FIG. C

PROJ - EGEDFORM.FRM - FEB 96

J5D002B-1

FOR PROPRIETARY NOTICE SEE SHEET A1		
VIDEO DISPLAY CABINET MCC/STLWS	THIRD ANGLE PROJ 	
(P) DWG SIZE C2	ISSUE 13	SHEET NO. C6
LUCENT TECHNOLOGIES	J5D002B-1	MODEL NAME

845310283 UPPER DOOR FRAME ASSEMBLY  
~~843077900 BEZEL E/W TWO 843077942 BRACKET LIST I~~  
~~843077900 BEZEL AND TWO 843077942 BRACKET LIST I~~  
 846364842 UPPER DOOR FRAME ASSEMBLY  
 E/W ED5D694-30.G2 BEZEL  
 LIST IA OR IB, IC, ID

845310283 UPPER DOOR FRAME ASSEMBLY  
 LIST I  
 846364842 UPPER DOOR FRAME ASSEMBLY  
 LIST IA OR IB, IC, ID

843077900 BEZEL E/W TWO 843077942 BRACKET AND TWO 843084104 PANEL LIST I  
 ED5D694-30.G2 BEZEL  
 LIST IA OR IB, IC, ID

846940252 FRAME ASSEMBLY

~~843077900 DOOR FRAME ASSEMBLY~~

~~843077900 DOOR ASSEMBLY (LI)~~  
 845622976 DOOR ASSEMBLY (LIA)

847902764 DOOR FRAME ASSY. (UPPER)  
 E/W 901252270 (2) SCREWS

ED5D184-77 GROUP 3 DOOR ASSY KIT

847901246 DOOR ASSEMBLY

SEE DETAIL A

843062100 FRAME SUPPORT ASSEMBLY

847902756 DOOR FRAME ASSY. (LOWER)  
 901252262 (4) SCREWS  
 901252270 (2) SCREWS

845310291 LOWER DOOR FRAME ASSEMBLY

RIGHT SIDE VIEW

FIG. 2  
 FRAME WORK AND EQUIPMENT  
 FOR SHORT DOOR ASSY.  
 LIST ID

PROJ-EGEDFORM.FRM-FEB-96

J5D002B-1

FOR PROPRIETARY NOTICE SEE SHEET A1		
VIDEO DISPLAY CABINET MCC/STLWS	THIRD ANGLE PROJ 	
(P) DWG SIZE C2	ISSUE 13	SHEET NO. C7
LUCENT TECHNOLOGIES	J5D002B-1	MODEL NAME

STOCKLIST								
ITEM NBR	LIST GROUP CODE	QTY PER CODE	PRODUCT IDENTIFIER	CODE	DESCRIPTION	REFERENCE POSITION	NOTE	
							SYM	NBR
1000	1,1A,1B,1C,1D,1E	1	846940252		ASSEMBLY,FRAME			
1010	1	1	843077892		ASSEMBLY,DOOR FRAME			
1011	1	2	845310283		ASSEMBLY,DOOR FRAME UPPER			
1015	1A,1B,1C,1D,1E	2	846364842		ASSEMBLY,DOOR FRAME UPPER			
1018	1D,1E	1	ED5D184-77,G3,G3		ASSEMBLY, FRAME & MCC PRINTER CABINET			
1020	1,1A,1B,1C	1	843082082		ASSEMBLY,DOOR FRAME			
1030	1	1	843079815		ASSEMBLY,DOOR			
1035	1A,1B,1C,1D	1	845622976		ASSEMBLY,DOOR PERFORATED (CENTER-OPENING)		S	
1040	1,1A,1B,1C	1	843082116		ASSEMBLY,DOOR			
1050	1	2	843077900		BEZEL			
1055	1A,1B,1C,1D,1E	2	ED5D694-30,G2,G2,G2,G2		ASSEMBLY, BEZEL COVER			
1060	1	4	843077942		BRACKET			
1070	1	1	843082215		ASSEMBLY,BEZEL FRAME			
1071	1	1	845310291		ASSEMBLY,DOOR FRAME LOWER			
1075	1A,1B,1C,1D,1E	1	845623099		ASSEMBLY,DOOR FRAME LOWER			
1080	1,1A,1B,1C,1D,1E	1	843062100		ASSEMBLY,FRAME SUPPORT			
1090	1,1A,1B,1C,1D,1E	1	843082249		BRACKET,ASSEMBLY LEFT			
1100	1,1A,1B,1C,1D,1E	1	843082256		BRACKET,ASSEMBLY RIGHT			
1110	1,1A,1B,1C,1D,1E	2	843082280		ANGLE			
1120	1,1A,1B,1C,1D,1E	1	843082892		ASSEMBLY,COVER			
1130	1,1A,1B,1C,1D,1E	1	843081928		PANEL			
1140	1	2	843084104		PANEL			
1150	1	1	844661066		DOORSTOP			12
1160	1,1A,1B,1C,1D,1E	1	843081977		ASSEMBLY,SHELF			
1170	1,1A,1B,1C,1D,1E	1	843081993		ASSEMBLY,DRAWER			
1180	1,1A,1B,1C,1D,1E	1	843081985		ASSEMBLY,KEYBOARD PANEL			
1190	1,1A	1	843082157		ASSEMBLY,PANEL LEFT SIDE			
1191	1B,1C,1D,1E,F	1	846860757		ASSEMBLY,SIDE PANEL, LEFT .063 STEEL			
1200	1,1A,1B,1C,1D,1E	1	843082207		ASSEMBLY,SHELF VIDEO DISPLAY			
1210	1,1A,1B,1C,1D,1E	2	843082199		BRACKET,MOUNTING			
1220	1,1A,1B,1C,1D,1E	1	843084781		INSULATOR			
1230	1,1A	1	843084740		ASSEMBLY,PANEL RIGHT SIDE			

STOCKLIST CONTINUED ON SHEET D2

J5D002B-1

S  
H  
O  
P  
I  
N  
S  
T  
R  
U  
C  
T  
I  
O  
N

MANUFACTURING NOTES

1. X PARTS REQUIRED FOR INSTALLATION.
- X/ PARTS REQUIRED FOR MANUFACTURE WHEN EQUIPMENT IS SHOP MOUNTED OR BY THE INSTALLER WHEN THE EQUIPMENT IS TO BE FIELD MOUNTED.
- \* PARTS THAT ARE TO BE SHIPPED ATTACHED TO OR ENCLOSED IN THE SAME CONTAINER WITH THE ASSOCIATED ASSEMBLED ITEM.
- \*/ PARTS (A) REQUIRED FOR MANUFACTURE WHEN EQUIPMENT INVOLVED IS SHOP MOUNTED OR (B) TO BE SHIPPED ATTACHED TO, OR ENCLOSED IN THE SAME CONTAINER WITH THE ASSOCIATED ASSEMBLED ITEM WHEN FIELD MOUNTED.
- ( ) INDICATES DESIGNATIONS TO BE STAMPED IN ACCORDANCE WITH JOB INFORMATION.
- { } INDICATES DESIGNATIONS SHOWN FOR INFORMATION ONLY AND ARE NOT TO BE STAMPED.
- < > INDICATES DESIGNATIONS AND/OR INFORMATION PROVIDED IN ACCORDANCE WITH OTHER INFORMATION.
- "W" PARTS ASSEMBLED AT THE SAME TIME THE EQUIPMENT IS MOUNTED.
- "W\*" PARTS TO BE (A) SHOP ASSEMBLED, BUT WHICH CANNOT BE ASSEMBLED UNTIL THE ASSOCIATED EQUIPMENT IS BEING MOUNTED, OR (B) SHIPPED ATTACHED TO, OR ENCLOSED IN THE SAME CONTAINER WITH THE ASSOCIATED EQUIPMENT WHEN FIELD MOUNTED.
- "S" PARTS NOT ASSEMBLED, SHIPPED SEPARATELY.
- A/R AS REQUIRED.
- "B" PARTIAL ASSEMBLIES ON OTHER DRAWINGS WITH STOCKLISTS.
- X X 12. &THE DOORSTOP IS REQUIRED FOR THE CABINET THAT IS ADJACENT TO THE MCC/STLWS. THE DOORSTOP IS TO BE PLACED IN THE CABINET DOOR TRACK IN SUCH A MANNER AS TO PREVENT THE DOORS FROM MAKING CONTACT WITH THE SHELF ON THE MCC/STLWS.&
- X 13. THE HANDSET EQUIPPED WITH THE TELEPHONE SET SHALL BE SHIPPED ATTACHED TO OR ENCLOSED IN THE SAME CONTAINER.
- X X 14. THE CABINET DESIGNATION LABELS ARE TO BE JOB ENGINEERED, THE COMCODES ARE TO BE ASSIGNED USING TABLE AA. THE COMCODE USED ON THE STOCKLIST IS FOR ACCOUNTING PURPOSES ONLY.
- X X 15. THE BAY DESIGNATION FOR THIS CABINET WILL ALWAYS BE 0.
- X X 16. THE CABINET DESIGNATION LABELS ARE TO BE JOB ENGINEERED USING THE ED5D695-10 GROUPS SHOWN IN TABLE AB.

COPYRIGHT © 2001 LUCENT TECHNOLOGIES  
ALL RIGHTS RESERVED

5ESS SWITCHING EQUIPMENT  
SPECIFICATION FOR  
VIDEO DISPLAY CABINET  
MCC/STLWS

BT13	
DWG SIZE C2	ISSUE 18
SHEET D1 OF 15	

LUCENT TECHNOLOGIES INC J5D002B-1

STOCKLIST									
ITEM NBR	LIST GROUP CODE	QTY PER CODE	PRODUCT IDENTIFIER	CODE	DESCRIPTION	REFERENCE POSITION	NOTE		
							SYM	NBR	
1231	1B,1C,1D,1E,F	1	846860765		ASSEMBLY,SIDE PANEL, RIGHT .063 STEEL				
1240	1,1A,1B,1C,1D,1E	8	843082769		ANGLE				
1250	1,1A,1B,1C,1D,1E	4	843082066		ASSEMBLY,PANEL SIDE				
1260	1,1A,1B,1C,1D,1E	2	843081944		ASSEMBLY,SHELF				
1270	1,1A	1	843084757		PANEL,BACK				
1271	1B,1C,1D,1E,F	1	846860773		PANEL,BACK .063 STEEL				
1280	1,1A,1B,1C,1D,1E	38	840059059		SCREW,PAN HEAD MACHINE .164-32 X 5/16 STEEL 289A FINISH				
1290	1,1A,1B,1C,1D,1E	8	840059810		SCREW,PAN HEAD MACHINE .190-32 X 1/4IN.STEEL 289A FINISH				
1300	1,1A,1B,1C,1D,1E	8	840026835		SCREW,TTF SLOTTED HEX, WASHER HD .216-24 X 5/8 TAPPING TYPE (SWAGE FORM) STEEL ZINC PLATE 289A FINISH				
1310	1,1A,1B,1C,1D,1E	16	900046558		SCREW,HEX WASHER HEAD SLOTTED .216-24 X 1/2 IN. PARKER-KALON				
1320	1,1A,1B,1C,1D,1E	34	801829144	P-182914	NUT,HEXAGON .164-32				
1330	1	8	840058234		SCREW,PAN HEAD MACHINE .112-40 X 3/16 STEEL 289A FINISH				
1340	1,1A,1B,1C,1D,1E	4	802512350	P-251235	NUT,HEXAGON .190-32				
1350	1,1A,1B,1C,1D,1E	3	840060172		SCREW,PAN HEAD MACHINE .216-24 X 5/16 STEEL 289A FINISH				
1370	1,1A,1B,1C,1D,1E	4	843084385		SCREW,HEXAGON HEAD CAP .500-13 X 5 3/4				*/
1380	1,1A,1B,1C,1D,1E	4	814251914	P-42E191	WASHER,PLAIN .090 STEEL 289A FINISH				*/
1390	1,1A,1B,1C,1D,1E	4	843082470		SPACER				*/
1400	1,1A,1B,1C,1D	4	900666256		NUT,TOPLock FLANGE CADMIUM FINISH #NF1213S GRIPCO FASTENER CO				*/
1410	2,2A,2B	OMIT 1	843082892		ASSEMBLY,COVER				
1414	2B	1	ED5D092-30,G2B		UNIT, TEST ACCESS				
1415	2A	1	ED5D092-30,G2A		UNIT, TEST ACCESS				
1416	2C	1	ED5D092-30,G500		UNIT, TEST ACCESS				
1420	2	1	ED5D092-30,G2		UNIT, TEST ACCESS				
1425	C	1	ED5D092-30,GA		UNIT, TEST ACCESS				
1430	3	1	103887014	91C	CONNECTOR BLOCK,CONNECTOR				*/
1440	3	1	102593100	261C-118	FACEPLATE				
1450	3	1	100672666	52L	HEADSET,TELEPHONE CLEI = TEHSE00EAA				
1460	3	1	841021678		HOOK,HANDSET				
1470	4	1	843082009		ASSEMBLY,PANEL TELEPHONE				
1480	4	1	103870721	2983A01-50	SET,TELEPHONE ATTIS				
1490	1,1A,5	1	845080969		ASSEMBLY,PANEL TELEPHONE				
1491	1B,F	1	846860781		ASSEMBLY,TELEPHONE PANEL .062 STEEL				
1500	5	1	103870705	2981A01-50	SET,TELEPHONE				13

\*\*\*\*\* STOCKLIST CONTINUED AT RIGHT \*\*\*\*\*

STOCKLIST									
ITEM NBR	LIST GROUP CODE	QTY PER CODE	PRODUCT IDENTIFIER	CODE	DESCRIPTION	REFERENCE POSITION	NOTE		
							SYM	NBR	
1510	5	1	845080977		ASSEMBLY,BRACKET				
1520	5	1	845081009		BRACKET				
1535	A,B	2	845081967		LABEL,BLANK				
1540	A	2	845082585		LABEL,CABINET DESIGNATION				
1541	D	2	ED5D695-10,G1494		LABEL, CABINET ADDRESS				
1555	B	2	845082601		LABEL,CABINET DESIGNATION				14 15
1557	E	2	ED5D695-10,G1350		LABEL, CABINET ADDRESS				14 16
1560	1,1A,1B	2	100274570	223A	JACK				
1565	1C,1D,1E	2	405253519		JACK #MT331 SWITCHCRAFT				
1570	1,1A,1B,1C,1D,1E	2	100046978	542G	CAPACITOR 4 UF				
1580	2,2A	OMIT 2	100274570	223A	JACK				
1590	2,2A,2B	OMIT 2	100046978	542G	CAPACITOR 4 UF				
1595	2B	OMIT 2	405253519		JACK #MT331 SWITCHCRAFT				
1600	2,2A,2B	1	844660738		LABEL				
1610	1A,1B	4	996096970		SCREW,SHOULDER #1327 PIC DESIGN CORP.				
1611	1B,1C,1D,1E	4	406763276		SCREW,HEX HEAD SLOTTED .190-32 STAINLESS STEEL #ATT04034SP CAMCAR TEXTRON				
1620	1A,1B,1C,1D,1E	4	900559121		WASHER,SPRING #UN250-0110 ASSOCIATED SPRING CO.				
1630	2,2A,2B	OMIT 1	843084781		INSULATOR				
1640	2,2A,2B	2	845081991		LABEL,ESD				
1650	2,2A,2B	2	840026835		SCREW,TTF SLOTTED HEX, WASHER HD .216-24 X 5/8 TAPPING TYPE (SWAGE FORM) STEEL ZINC PLATE 289A FINISH				
1660	2,2A,2B	2	405701756		TERMINAL,LUG #M8-14R/SX 3M CO.				
5000	500	1	846940252		ASSEMBLY,FRAME				
5010	501	1	405253519		JACK #MT331 SWITCHCRAFT				
5020	502	2	846364842		ASSEMBLY,DOOR FRAME UPPER				
5030	503	1	843082082		ASSEMBLY,DOOR FRAME				
5040	504	1	843082116		ASSEMBLY,DOOR				
5050	505	1	845623099		ASSEMBLY,DOOR FRAME LOWER				

\*\*\*\*\* END OF STOCKLIST \*\*\*\*\*

COPYRIGHT © 2001 LUCENT TECHNOLOGIES  
ALL RIGHTS RESERVED

BT13

5ESS SWITCHING EQUIPMENT  
SPECIFICATION FOR  
VIDEO DISPLAY CABINET  
MCC/STLWS

DWG SIZE C2 ISSUE 18

J5D002B-1

LUCENT TECHNOLOGIES INC J5D002B-1

SHEET D2 OF 15

PRINTED IN U.S.A.

TABLE AA

COMCODE	DESIGNATION TO BE PRINTED					LINE
	POS 1		POS 2		POS 3	
	ABBR	NBR	ABBR	NBR	NBR	
845082601	STLWS	0	BAY	0	D0	1
845082619	STLWS	1	BAY	0	D0	
845082627	STLWS	2	BAY	0	D0	
845082635	STLWS	3	BAY	0	D0	5
845082643	STLWS	4	BAY	0	D0	
845082650	STLWS	5	BAY	0	D0	
						10
						15

TABLE AB

ED5D695-10	DESIGNATION TO BE PRINTED					LINE
	POS 1		POS 2			
	ABBR	NBR	ABBR	NBR		
1350	STLWS	0	BAY	0		1
1351	STLWS	1	BAY	0		
1352	STLWS	2	BAY	0		
1353	STLWS	3	BAY	0		
1354	STLWS	4	BAY	0		5
1355	STLWS	5	BAY	0		

TABLE D4

TABLE D4 - FUNCTION ITEM/FUNCTIONAL OBJECT/ORDER CODE MAPPING			
FUNCTIONAL ITEM	NOTE	DESCRIPTION	ORDER CODE
DOORLOW		LOWER DOOR FRAME ASSEMBLY	845623099
DOORUP		UPPER DOOR FRAME ASSEMBLY	846364842
DORASSY		DOOR ASSEMBLY	843082116
DORFRASSY		DOOR FRAME ASSEMBLY	843082082
MCC/STLWS		CABINET/VIDEO DISPLAY	J5D002B-1
MCCABV		FRAME ASSEMBLY	846940252
SAFETY		LABEL/LUG	847513470
TELJK		TELEPHONE JACK #MT331	405253519

TABLE D5

TABLE D5 - OBJECT/HARDWARE TYPE ATTRIBUTES/ORDER CODE MAPPING							
OBJECT:	INTERFACE CHARACTERISTICS	MINIMUM US GENERIC	MINIMUM INTL GENERIC	EXCHANGE TYPE	FEATURE/OPTION	COUNTRY CUSTOMER	ORDER CODE
OBJECT:DOORLOW							845623099
OBJECT:DOORUP							846364842
OBJECT:DORASSY							843082116
OBJECT:DORFRASSY							843082082
OBJECT:MCC/STLWS							J5D002B-1
OBJECT:MCCABV							846940252
OBJECT:SAFETY							847513470
OBJECT:TELJKMT							405253519

TABLE D6

TABLE D6 - NSI TYPE DESIGNATION LABEL		
UNIT ATTRIBUTES		REFERENCE CODE
COUNTRY	OTHER	

TABLE D7

TABLE D7 - FRONT NSI TYPE DESIGNATION LABEL					
UNIT ATTRIBUTES				REFERENCE TEMPLATE	SHELF #
EXCHANGE TYPE	COMMUNITY NUMBER	LINE GROUP NUMBER			

TABLE D8

MODIFY TAG: MCC2B

TABLE D8 - REAR NS TYPE DESIGNATION LABEL								
APPARATUS		UNIT ATTRIBUTES				MIN APPARATUS		REFERENCE
CODE	H EQL	INTERFACE CHARACTERISTIC	MINIMUM RELEASE	EXCHANGE TYPE	FEATURE/ OPTION	CODE	H EQL	TEMPLATE

COPYRIGHT © 2001 LUCENT TECHNOLOGIES  
ALL RIGHTS RESERVED

BT13

5ESS SWITCHING EQUIPMENT  
SPECIFICATION FOR  
VIDEO DISPLAY CABINET  
MCC/STLWS

DWG SIZE C2	ISSUE 18
----------------	-------------

J5D002B-1

LUCENT TECHNOLOGIES INC J5D002B-1

SHEET D4 OF 15
-------------------

PRINTED IN U.S.A.