


SHEET INDEX		
CONTENTS	SHEET NO	SHEET ISSUE NO
SHEET INDEX SUPPORTING INFORMATION SYSTEM USED ON DESIGN CONTROL OPTION INDEX	A1	SAC
FS 1	B1, B5	SAC
FS 2 - OPTION BOARD	B2	7
FS 3	B3	3
FS 4	B4	6
APP FIG. 1	C1	SAC
APP FIG. 2	C2	5
CIRCUIT NOTES EQUIPMENT NOTES	D1	SAC
INFORMATION NOTES	D2	SAC
CAD 1, 2, 3, 4, 5	G1	5

OPTION INDEX			
APP OR WRG	RATED OR ISSUE	REF NOTES	LOCATION
Z	1		1A6, 1A7, 1B6, 1B7
Y	1		1A6, 1A7, 1B6, 1B7
W	1		APP FIG. 1, 2, 1A4, 1B4, 1E3, 1F2, 2D5, 2D6, 2D8, 2F2, 2F8
V	1		APP FIG. 1, 2, 1A4, 1B4, 1E3, 1F2, 2D5, 2D6, 2D8, 2F2, 2F8
T	1		2D3, 2F3
Q	1		2E3, 2F3
N	1	203	APP FIG. 2, 2F1
M	1		2F4
K	1	203	APP FIG. 2, 2F0
F	1	203	APP FIG. 2, 2F0
ZA	1		2F4, 2F5
ZJ	1		2E2
ZM	3	317	
ZN	3	317	
ZP	5B		FS1, APP FIG. 1
ZQ	7AC		FS1
ZR	7AC		FS1, APP FIG. 1
ZS	8A		FS1, APP FIG. 1
ZT	8A		FS1, APP FIG. 1
ZV	9AC		FS1, APP FIG. 1
ZW	9AC		FS1


DWG ISSUE	CD ISSUE	DATE ISSUED	BY	APPD
1	1	9-1-87		
2A	2A	12-14-87		
3B	2A APPX 1B	2-24-88		
4H				
5B		4-5-88		
6M		5-17-88		
7AC		6-27-88		
8A		11-10-88		
9AC		8-25-88		

SYSTEM USED ON	DESIGN CONTROL
POWER	WH/PK

SUPPORTING INFORMATION		Copyright © 1987 AT&T All Rights Reserved	
CATEGORY	NO	DWG SIZE	ISSUE
OPERATING AND MAINTENANCE	ATTP-169-790-106	6S	SAC
PRODUCT MANUAL	115-014		
MANUFACTURING TESTING REQUIREMENTS	X-80060 160-700-72		
		POWER SYSTEMS "LINEAGE" 2000 RECTIFIER CIRCUIT INPUT: 208 OR 240 VOLTS, 60 Hz OUTPUT: 24 VOLTS OR 48 VOLTS 1.25 AMPERES J85502C	
AT & T		SD-82659-01	
		SHEET A1 OF 11	

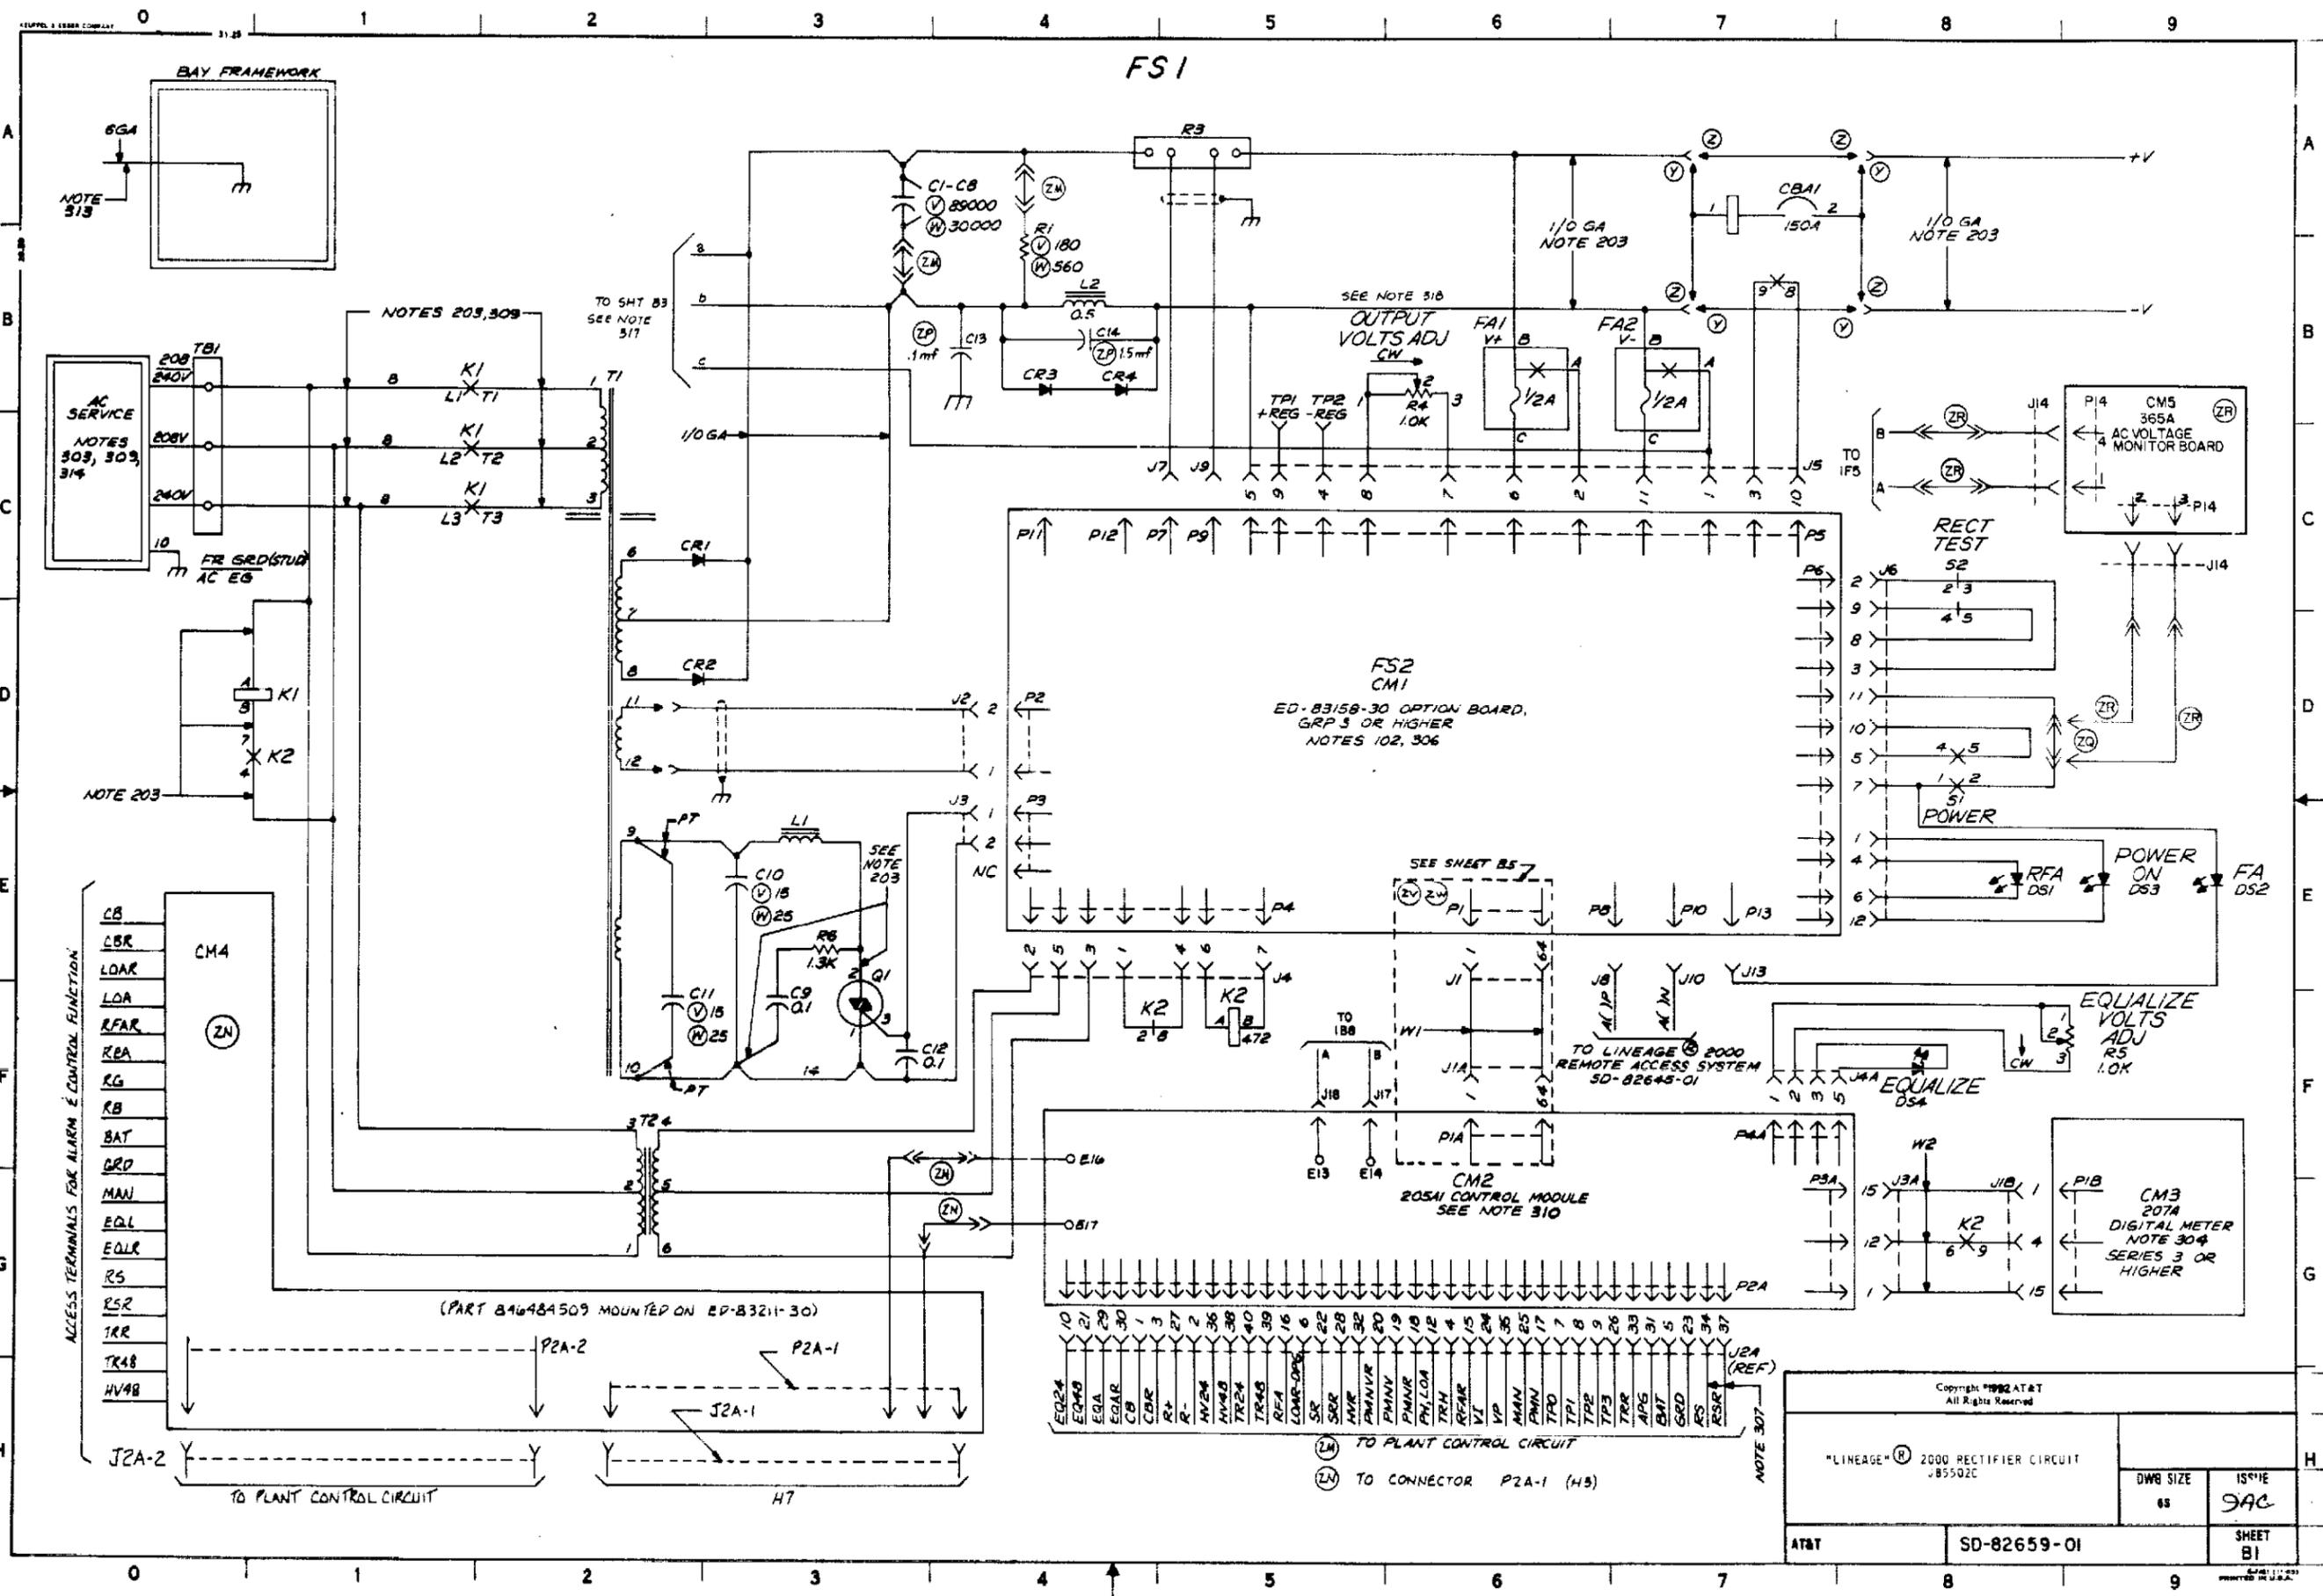

FS 2
OPTION BOARD
SEE NOTE 2

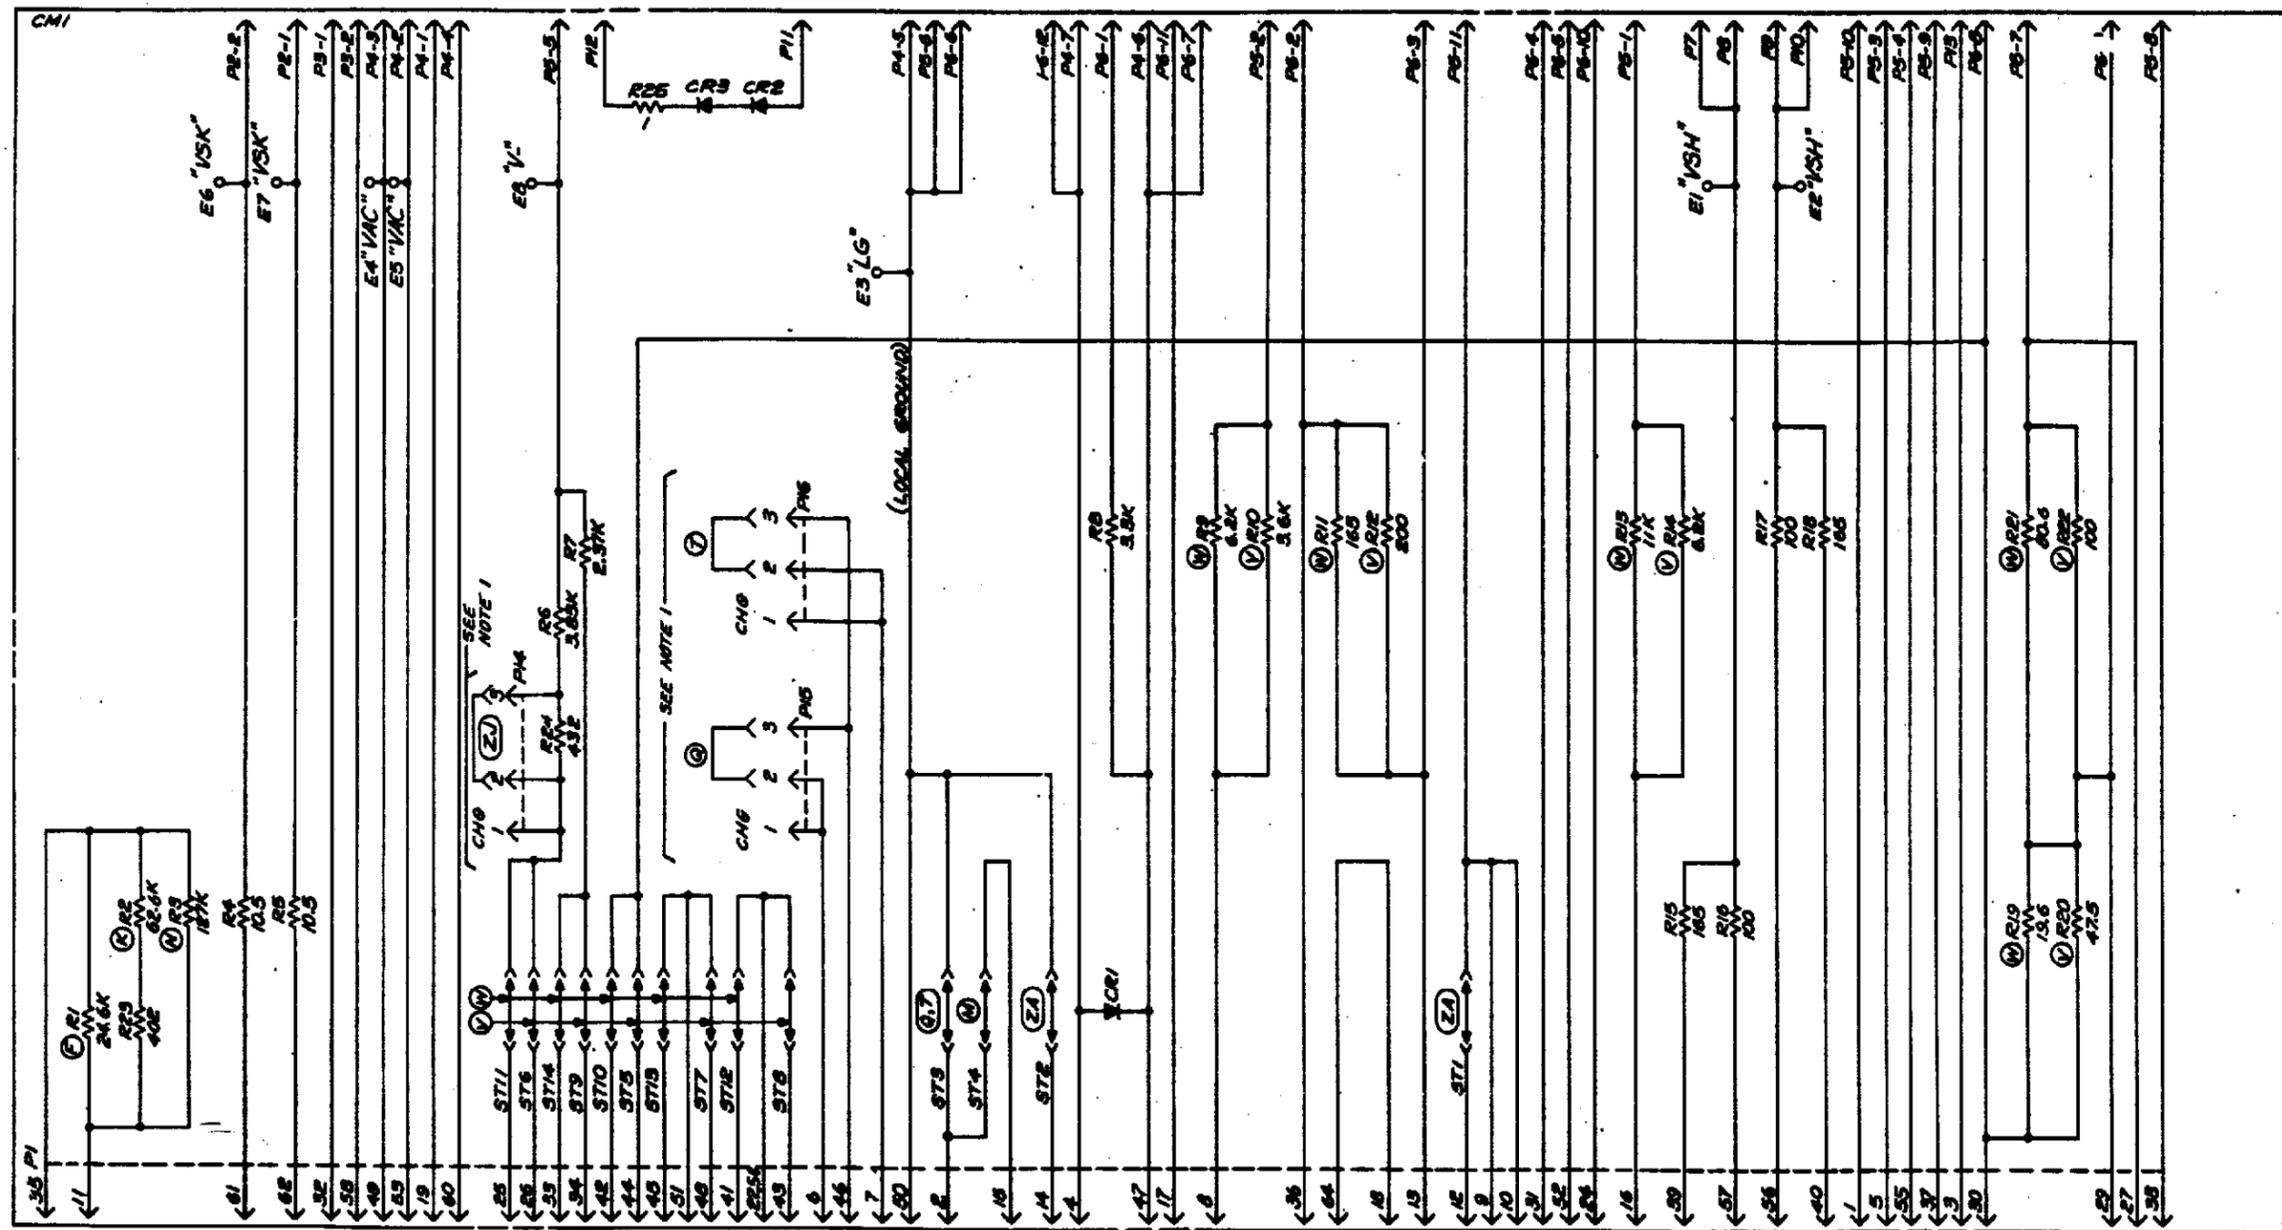


NOTES:

- IN APPLICATIONS WHERE EXTERNAL HIGH VOLTAGE SHUTDOWN SIGNAL IS NOT AVAILABLE (OPTIONS 8 OR 1), TO RAISE LEVEL OF BACKUP HIGH VOLTAGE SHUTDOWN VOLTAGE DURING INITIAL CHARGE, MOVE CONNECTORS P14, P15 & P16 TO CHG POSITION. UNDER NORMAL OPERATION WHERE EXTERNAL IN SHUTDOWN SIGNAL IS AVAILABLE (OPTION 8), P15 & P16 CONNECTORS ARE ALREADY IN CHG POSITION. IN THIS CASE, INITIAL CHARGE CAN BE ACCOMPLISHED BY MOVING CONNECTOR P14 TO CHG POSITION. SEE INFORMATION NOTES 305 & 306 FOR INSTRUCTIONS ON REMOVAL OF OPTION STRAPS AND RESISTORS. SEE FS4-3 APP FIG. 2, OPTION 20 OF SD-82604-01. SEE SD-82604-01 FS4 / APP FIG. 2 OPTION 20.
- FOR RECORD ONLY. SD-82604-01 IS THE CONTROLLING DOCUMENT. SEE FS4-3 APP FIG. 2, OPTION 20 OF SD-82604-01.

Copyright © 1964 AT&T All Rights Reserved		
"LINEAGE" 2000 RECTIFIER CIRCUIT J85502C		DWG SIZE 68
SD-82659-01		ISSUE 7AC
AT&T		SHEET 82

FS 3
BATTERYLESS OPTION BOARD

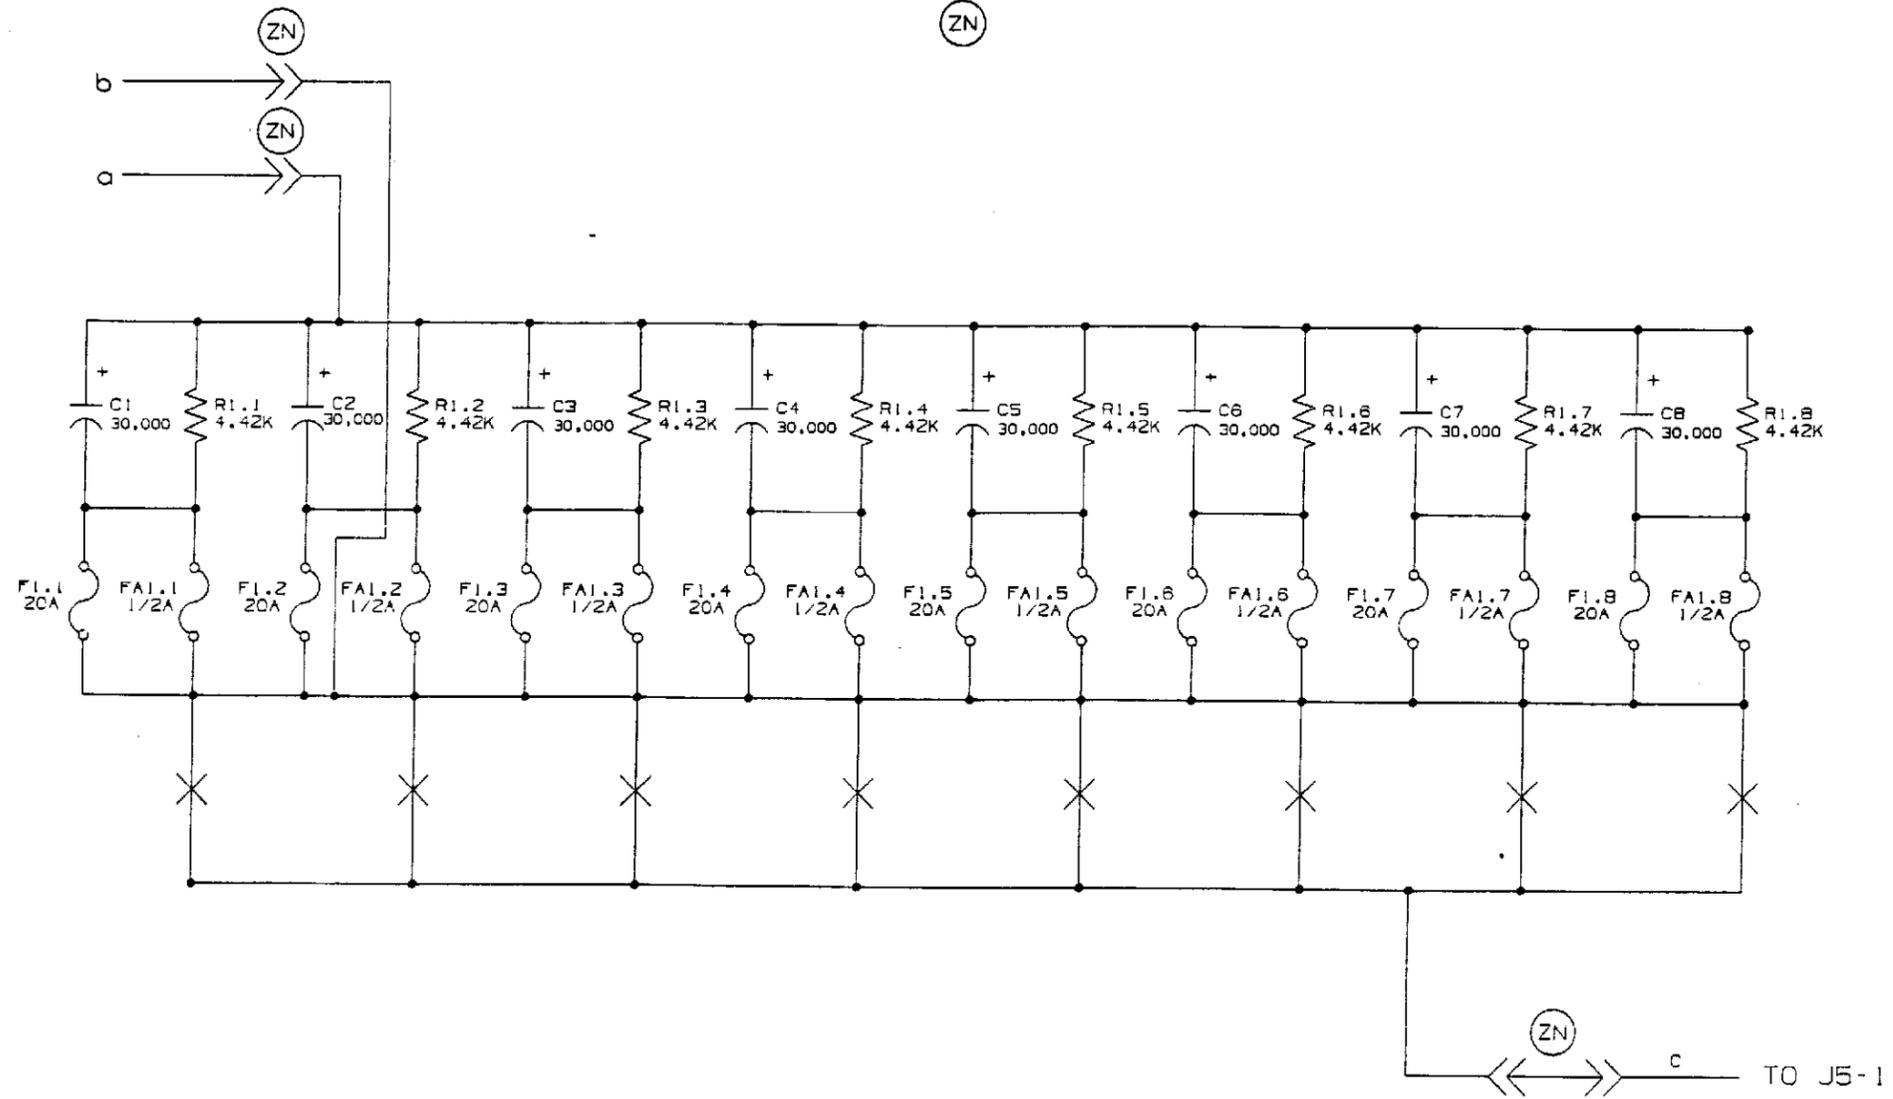

Copyright 1990 AT&T
All Rights Reserved


"LINEAGE" © 2000 RECTIFIER CIRCUIT
J85502C

DRG. SIZE ISSUE
65 38

AT&T - PROPRIETARY
USE PERMIT TO

FS4
PWB 846484509 ED03211-00 BOARD




(ZN)

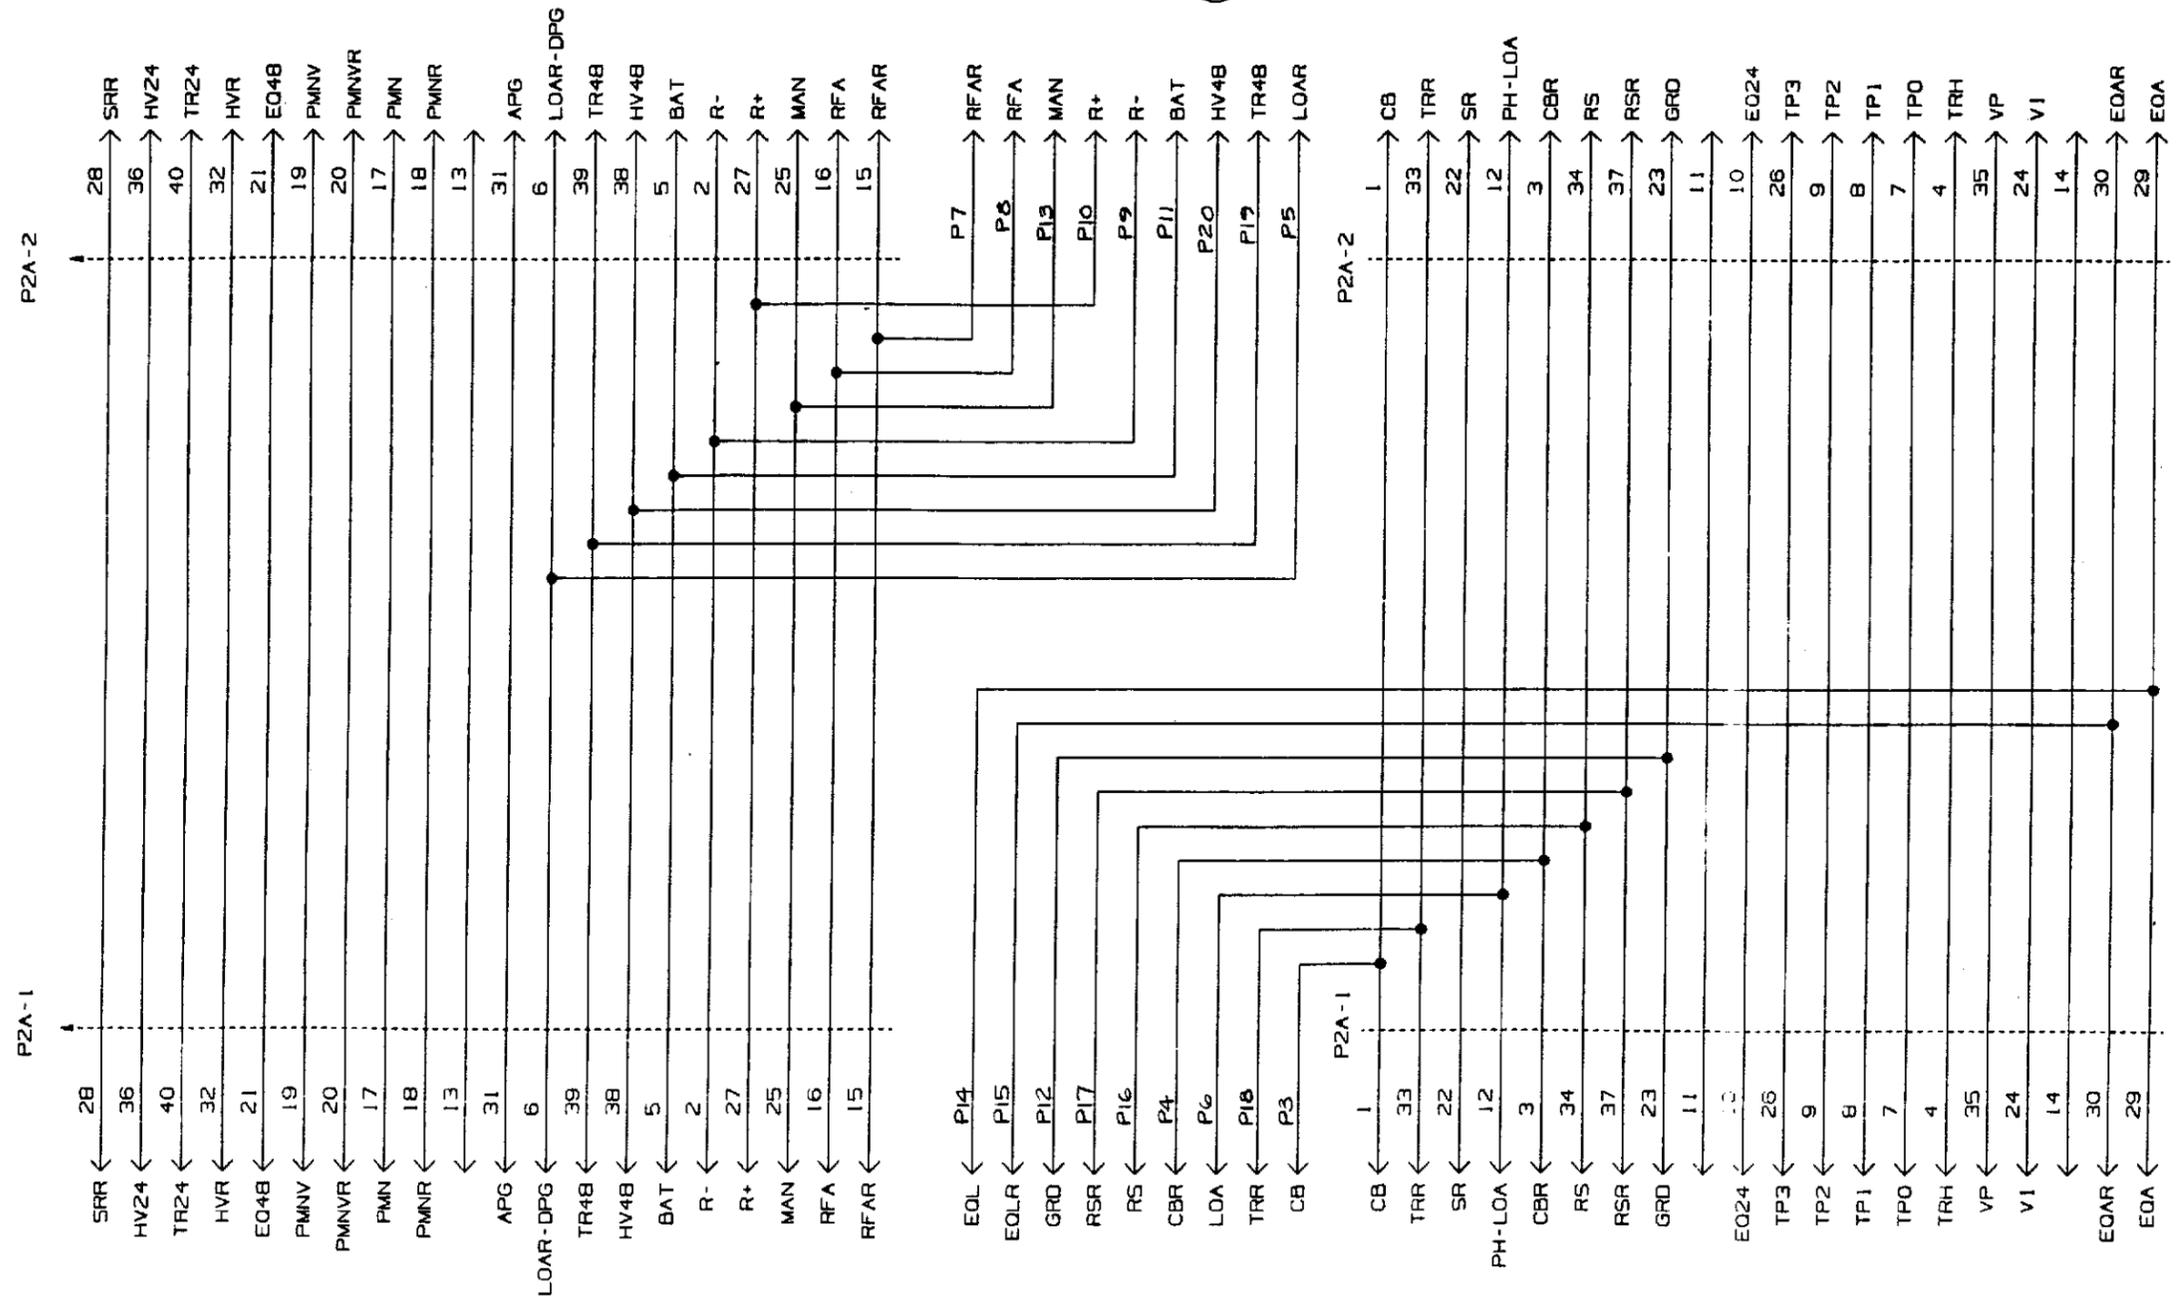

AT&T - PROPRIETARY
USE PURSUANT TO
COMPANY INSTRUCTIONS


Copyright 1990 AT&T All Rights Reserved	
"LINEAGE" © 2000 RECTIFIER CIRCUIT J65502C	DWG. SIZE 65 GM
AT&T	SHEET B4
SD-82659-01	

PART OF FSI

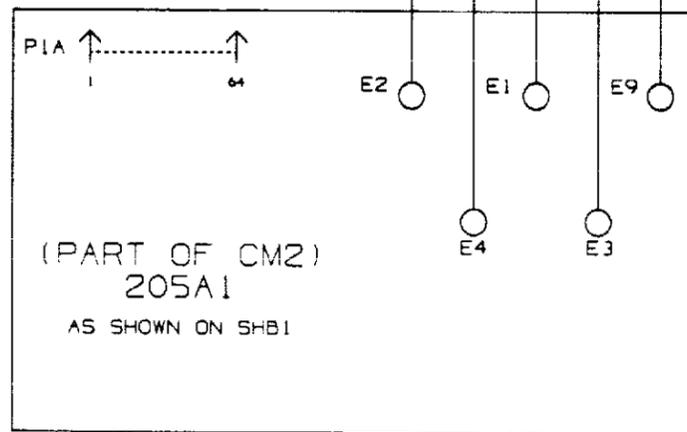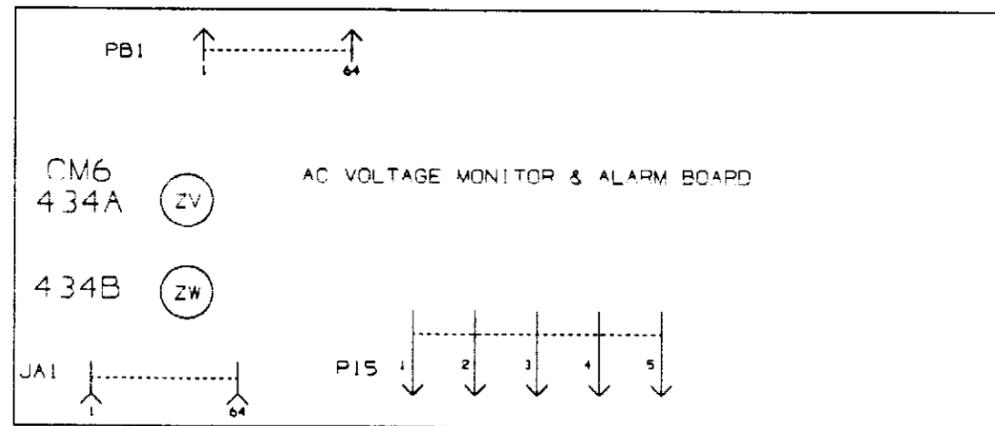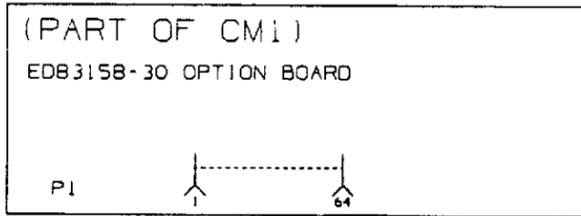



LINEAGE 2000 RECTIFIER CIRCUIT			
COPYRIGHT © 1994 AT&T ALL RIGHTS RESERVED			
AT&T	DJ	SDB265901	SHEET 85 ISSUE 9AC DWG SIZE C2

APP FIG. 1

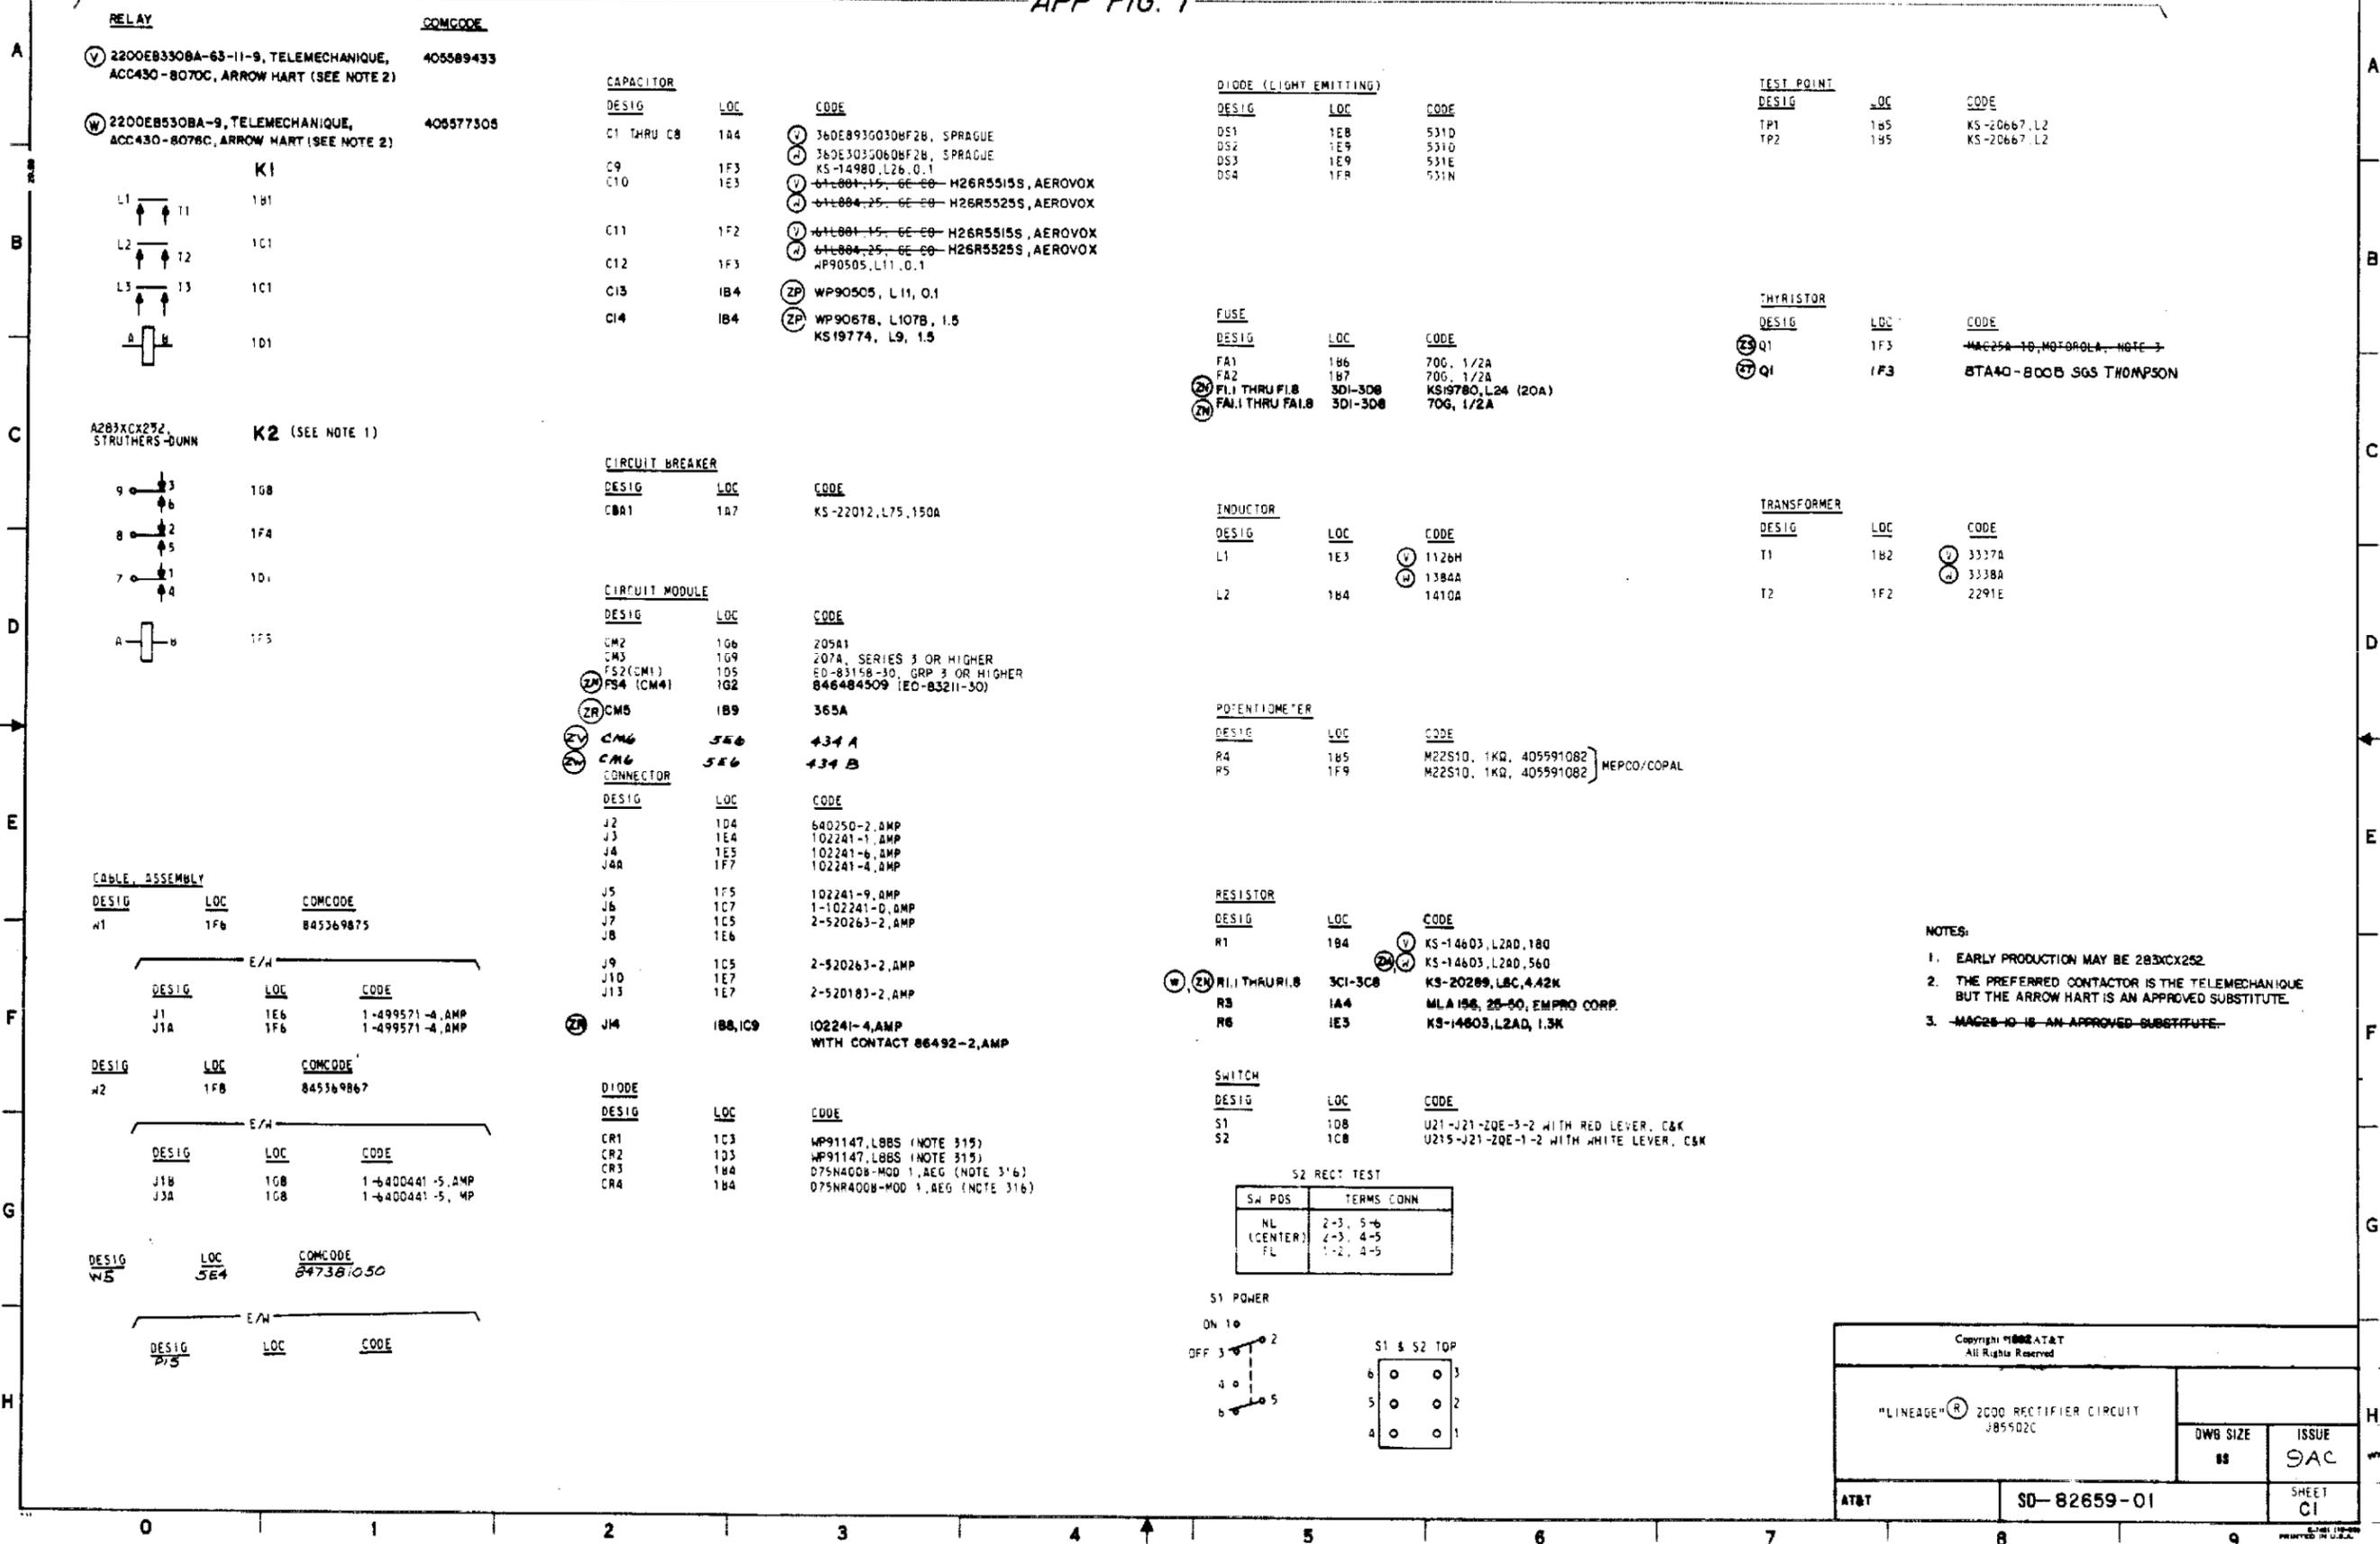

RELAY

RELAY	COMCODE
Ⓜ 2200EB3308A-63-11-9, TELEMECHANIQUE, ACC430-8070C, ARROW HART (SEE NOTE 2)	405589433
Ⓜ 2200EB5308A-9, TELEMECHANIQUE, ACC430-8076C, ARROW HART (SEE NOTE 2)	405577305

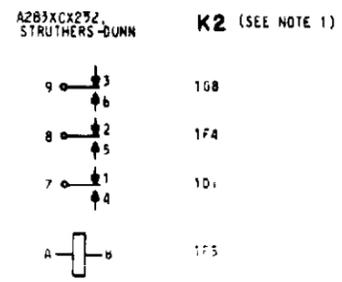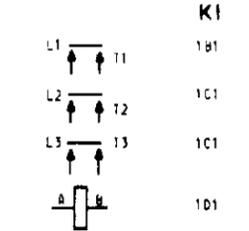

CABLE ASSEMBLY

DESIG	LOC	COMCODE
W1	1F6	845369875

DESIG	LOC	CODE
J1	1E6	1-499571-4, AMP
J1A	1F6	1-499571-4, AMP

DESIG	LOC	COMCODE
W2	1F8	845369867

DESIG	LOC	CODE
J1B	108	1-400441-5, AMP
J3A	108	1-400441-5, MP

DESIG	LOC	COMCODE
W5	5E4	847381050

DESIG	LOC	CODE
P75		

CAPACITOR

DESIG	LOC	CODE
C1 THRU C8	1A4	Ⓜ 360E893030BF2B, SPRAGUE
		Ⓜ 360E3035060BF2B, SPRAGUE
		KS-14980, L26, 0.1
		Ⓜ 61L801-15, GE-60-M26R5515S, AEROVOX
		Ⓜ 61L804-25, GE-60-M26R5525S, AEROVOX
C9	1F3	Ⓜ 61L801-15, GE-60-M26R5515S, AEROVOX
C10	1E3	Ⓜ 61L804-25, GE-60-M26R5525S, AEROVOX
C11	1F2	Ⓜ 61L801-15, GE-60-M26R5515S, AEROVOX
C12	1F3	Ⓜ 61L804-25, GE-60-M26R5525S, AEROVOX
C13	1B4	Ⓜ WP90505, L11, 0.1
C14	1B4	Ⓜ WP90678, L107B, 1.5
		KS19774, L9, 1.5

CIRCUIT BREAKER

DESIG	LOC	CODE
CBA1	1A7	KS-22012, L75, 150A

CIRCUIT MODULE

DESIG	LOC	CODE
CM2	106	205A1
CM3	109	207A, SERIES 3 OR HIGHER
FS2 (CM1)	105	ED-83158-30, GRP 3 OR HIGHER
PS4 (CM4)	102	846484509 (ED-83211-30)
Ⓜ CM5	1B9	365A
Ⓜ CM6	5E6	434 A
Ⓜ CM6	5E6	434 B

CONNECTOR

DESIG	LOC	CODE
J2	104	640250-2, AMP
J3	1E4	102241-1, AMP
J4	1E5	102241-6, AMP
J4A	1F7	102241-4, AMP
J5	1F5	102241-9, AMP
J6	1C7	1-102241-0, AMP
J7	1C5	2-520263-2, AMP
J8	1E6	
J9	1C5	2-520263-2, AMP
J10	1E7	
J13	1E7	2-520183-2, AMP
Ⓜ J14	1B8, 1C9	102241-4, AMP
		WITH CONTACT 86492-2, AMP

DIODE

DESIG	LOC	CODE
CR1	1C3	WP91147, LBBS (NOTE 315)
CR2	1D5	WP91147, LBBS (NOTE 315)
CR3	1B4	D75N4008-MOD 1, AEG (NOTE 316)
CR4	1B4	D75NR4008-MOD 1, AEG (NOTE 316)

DIODE (LIGHT EMITTING)

DESIG	LOC	CODE
DS1	1E8	531D
DS2	1E9	531O
DS3	1E9	531E
DS4	1FR	531N

FUSE

DESIG	LOC	CODE
FA1	1B6	70G, 1/2A
FA2	1B7	70G, 1/2A
Ⓜ FA1 THRU FA2	3D1-3D8	KS19780, L24 (20A)
Ⓜ FA1 THRU FA1.8	3D1-3D8	70G, 1/2A

INDUCTOR

DESIG	LOC	CODE
L1	1E3	Ⓜ 1126H
		Ⓜ 1384A
L2	1B4	Ⓜ 1410A

POTENTIOMETER

DESIG	LOC	CODE
R4	1B5	M22510, 1KΩ, 405591082
R5	1F9	M22510, 1KΩ, 405591082



MEPCO/COPAL

RESISTOR

DESIG	LOC	CODE
R1	1B4	Ⓜ KS-14603, L2AD, 18Ω
		Ⓜ KS-14603, L2AD, 56Ω
Ⓜ R1 THRU R1.8	3C1-3C8	KS-20289, LBC, 4.42K
R8	1A4	MLA 196, 25-50, EMPRO CORP.
R6	1E3	KS-14603, L2AD, 1.3K

SWITCH

DESIG	LOC	CODE
S1	108	U21-J21-ZQE-3-2 WITH RED LEVER, C&K
S2	1C8	U215-J21-ZQE-1-2 WITH WHITE LEVER, C&K

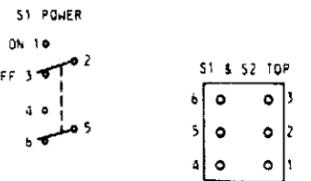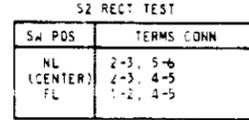

- NOTES:**
1. EARLY PRODUCTION MAY BE 283XC252
 2. THE PREFERRED CONTACTOR IS THE TELEMECHANIQUE BUT THE ARROW HART IS AN APPROVED SUBSTITUTE.
 3. MAC28-10 IS AN APPROVED SUBSTITUTE.

Copyright © 1968 AT&T
All Rights Reserved

"LINEAGE" 2000 RECTIFIER CIRCUIT
J85502C

DWG SIZE	ISSUE
88	SAC

AT&T SD-82659-01 SHEET C1

APP FIG. 2

SEE NOTE 1

CIRCUIT MODULE

DESIG LOC CODE
CM1 105.280 ED-83158-30, GRP 3

E/W

CONNECTOR

DESIG	LOC	CODE
P1	200	1-499460-2, AMP
P2-1	281	641119-2, AMP
P2-2	281	641119-2, AMP
P3-1	281	3-102202-4, AMP
P3-2	281	3-102202-4, AMP
P4-1	282	102202-5, AMP
P4-2	281	102202-5, AMP
P4-3	281	102202-5, AMP
P4-4	282	102202-5, AMP
P4-5	283	102202-5, AMP
P4-6	284	102202-5, AMP
P4-7	284	102202-5, AMP
P5-1	286	102202-8, AMP
P5-2	285	102202-8, AMP
P5-3	287	102202-8, AMP
P5-4	287	102202-8, AMP
P5-5	282	102202-8, AMP
P5-6	283	102202-8, AMP
P5-7	288	102202-8, AMP
P5-8	288	102202-8, AMP
P5-9	287	102202-8, AMP
P5-10	287	102202-8, AMP
P5-11	285	102202-8, AMP
P6-1	284	102202-9, AMP
P6-2	285	102202-9, AMP
P6-3	285	102202-9, AMP
P6-4	286	102202-9, AMP
P6-5	286	102202-9, AMP
P6-6	286	102202-9, AMP
P6-7	284	102202-9, AMP
P6-8	287	102202-9, AMP
P6-9	288	102202-9, AMP
P6-10	286	102202-9, AMP
P6-11	284	102202-9, AMP
P6-12	284	102202-9, AMP
P7	286	#836, ZIERICK
P8	287	#836, ZIERICK
P9	287	#836, ZIERICK
P10	287	#836, ZIERICK
P11	282	#836, ZIERICK
P12	283	#836, ZIERICK
P13	287	#836, ZIERICK
P14	202	#836, ZIERICK
P15	2E3	65568-103, BERG
P16	203	

RESISTOR

DESIG	LOC	CODE
R1	2F0	KS-16311, LAF, 24.6K
R2	2F0	KS-16311, LAF, 62.6K
R3	2F1	KS-16311, LAF, 127K
R4	2F1	WP90033, L1, 10.5
R5	2F1	WP90033, L1, 10.5
R6	2D2	WP90033, L1, 3.83K
R7	2D2	WP90033, L1, 2.37K
R8	2D4	KS-13490, L1, 3.3K
R9	2D5	KS-13490, L1, 6.2K
R10	2D5	KS-13490, L1, 3.6K
R11	2D5	WP90033, L1, 165
R12	2D5	WP90033, L1, 200
R13	2D6	KS-13490, L1, 11K
R14	2D6	KS-13490, L1, 6.2K
R15	2F6	WP90033, L1, 165
R16	2F6	KS-16311, LAF, 100
R17	2D7	KS-16311, LAF, 100
R18	2D7	WP90033, L1, 165
R19	2F8	WP90033, L1, 19.6
R20	2F8	WP90033, L1, 47.5
R21	2D8	WP90033, L1, 80.6
R22	2D8	WP90033, L1, 100
R23	2F0	WP90033, L1, 402
R24	2E2	WP90033, L1, 432
R25	2B2	KS-14609, L1AD, 1

TERMINAL

DESIG	LOC	CODE
E1	2C6	640967-2, AMP
E2	2C7	640967-2, AMP
E3	2C3	640967-2, AMP
E4	2B1	640967-2, AMP
E5	2B1	640967-2, AMP
E6	2B1	640967-2, AMP
E7	2B1	640967-2, AMP
E8	2B2	640967-2, AMP

DIODE

DESIG	LOC	CODE
CR1	2F4	WP90015, L3
CR2	2B3	6051, MICROSEMI CORP.
CR3	2B3	6051, MICROSEMI CORP.

NOTES:

1. FOR RECORD ONLY, SD-82604-01 IS THE CONTROLLING DOCUMENT.
SEE FS4 & APP FIG. 2, OPTION 2Q OF SD-82604-01.
SEE SD-82604-01 FS4 & APP FIG. 2, OPTION 2Q

APP FIG. 3

CIRCUIT MODULE

DESIG LOC CODE
CM4 1 H2, 480 ED-83211-30

E/W

CONNECTOR

DESIGN	LOC	CODE
P2A-1	1H3	499920-9 AMP
P2A-2	1G1	499917-9 AMP
P3	4	836 ZIERICK
P4	4	836 ZIERICK
P5	4	836 ZIERICK
P6	4	836 ZIERICK
P7	4	836 ZIERICK
P8	6	836 ZIERICK
P9	4	836 ZIERICK
P10	4	836 ZIERICK
P11	4	836 ZIERICK
P12	4	836 ZIERICK
P13	4	836 ZIERICK
P14	4	836 ZIERICK
P15	4	836 ZIERICK
P16	4	836 ZIERICK
P17	4	836 ZIERICK
P18	4	836 ZIERICK
P19	4	836 ZIERICK
P20	4	836 ZIERICK

CABLE ASSY

DESIG LOC CODE
WS IH3 846487924

E/W

DESIG	LOC	CODE
J2A-1	1H3	60598-9
J2A-2	1H2	60598-9

Copyright © 1974 AT&T All Rights Reserved.		
LINEAGE 2000 RECTIFIER CIRCUIT J85502C		DWG SIZE 85
		ISSUE 5B
AT&T	SD-82659-01	SHEET C2

CIRCUIT NOTES:

101.

DESIG	FUSE AMP	POTENTIAL	ONE PER
BATTERY SYMBOL		VOLTAGE RANGE	

FOR INPUT FUSING, SEE NOTE 309.

102. CM1 IS MANUFACTURED WITH ALL OPTION STRAPS AND RESISTORS IN PLACE. REMOVE UNNECESSARY STRAPS AND EXTRA RESISTORS. REFER TO NOTE 306 & 310.

FEATURE OR OPTION	PROVIDE		
	APP FIG.	APP OR ARG	QUANTITY
208/240 VAC INPUT	125 AMP 24V OUTPUT	1.2 V	1
	125 AMP 48V OUTPUT	1.2 W	1
OUTPUT GROUND	NEGATIVE	1	1
	POSITIVE	1	2
EXTERNAL HIGH VOLTAGE SHUTDOWN SIGNAL	NOT AVAILABLE	24 VOLTS	0, ZJ, ZP
	NOT AVAILABLE	48 VOLTS	1, ZJ
	AVAILABLE		M
EXTERNAL SENSING	NOT AVAILABLE		ZR
	AVAILABLE		-
PROVIDE LOCAL ACCESS TO CONTROL AND ALARM FUNCTIONS	1, 3	ZN	
PROVIDE AC VOLTAGE MONITOR CIRCUIT	1	ZR	
PROVIDE AC/DC VOLTAGE MONITOR AND SHUTDOWN CIRCUIT	1	ZV	
PROVIDE AC/DC VOLTAGE MONITOR AND SHUTDOWN CIRCUIT WITH AC VOLTAGE ALARM	1	ZW	

NOTES:
 1. FOR INITIAL CHARGE, THE CONNECTION B1A(21), B15(9) AND P1(1) ON THE OPTION BOARD SHOULD BE IN THE CHARGE POSITION.
 2. OPTION (G-1) IS AN OPTION THAT IS STRAPPED WHENEVER EXTERNAL HIGH VOLTAGE SHUTDOWN IS NOT AVAILABLE.

103.

CHANGED ON ISS	IF JOB RECORDS DO NOT SPECIFY	THIS OPTION WAS FURN	SEE NOTE	USE IN CIRCUIT		
				MAIL	LA	DA
3B	ZM, ZN	ZM	317, 318	ZM, ZN		NONE
TAC	ZQ, ZR	ZQ		ZR		NONE
BM	ZS, ZT	ZS		ZT		ZS
SAC	ZR, ZV, ZW	ZR		ZV, ZW, ZB		ZR

EQUIPMENT NOTES:

- 201. ALL WIRING SHALL BE KS-22247, L4 STRANDED UNLESS OTHERWISE SPECIFIED.
- 202. ALL WIRING OF UNSPECIFIED SIZE SHALL BE 22 GA.
- 203. WIRING SHALL BE KS-22247, L5 STRANDED FOR WIRING UP TO 6 GA. THE 1/0 GA WIRING SHALL BE KS-20921, L1.

Copyright © AT&T
All Rights Reserved

"LINEAGE"® 2000 RECTIFIER CIRCUIT
J85502C


DWG SIZE 65	ISSUE SAC
----------------	--------------

AT&T SD-82659-01 SHEET D1

INFORMATION NOTES:

301. UNLESS OTHERWISE SPECIFIED:
RESISTANCE VALUES ARE IN OHMS,
CAPACITANCE VALUES ARE IN MICROFARADS,
INDUCTANCE VALUES ARE IN MILLIHENRIES,
VALUES PRECEDED BY THE SYMBOL + (PLUS)
OR - (MINUS) ARE IN VOLTS.

302. THE TERMINAL NUMBER ASSIGNMENT OF THE TYPE ~~40C~~ 25-10
THYRISTOR IS:

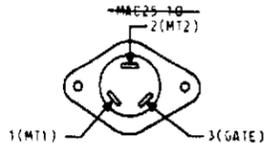


OPTION	INPUT VOLTAGE	
	NOMINAL	RANGE
S	208	184-220
R	240	208-254

304. 207A MUST BE SERIES 3 OR HIGHER.

305. DO NOT PARALLEL WITH THE RS LEADS OF THE J87434 OR J87435
RECTIFIERS.

306. THE OPTIONS ON CMI ARE LOCATED AS FOLLOWS:

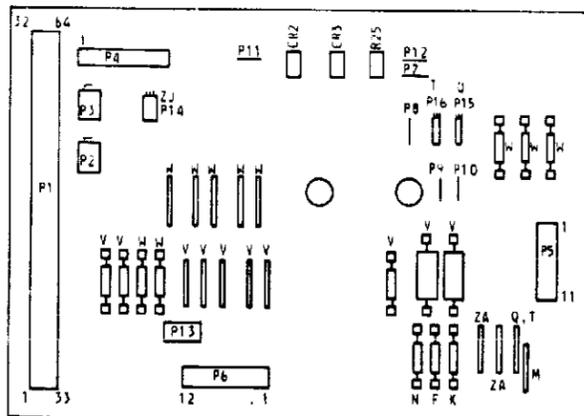

307. THE PLANT CONNECTION IS MADE WITH H285-224, L1() CABLE
ASSEMBLY PER SO-82588-01.

308. THIS CAD FIGURE SHOULD BE USED FOR INFORMATION ONLY.
CABLE ASSEMBLY AND PLANT INTERCONNECTIONS WILL BE
SPECIFIED BY PLANT SCHEMATIC.

INFORMATION NOTES: (CONT)

AC POTENTIAL	OUTPUT		LINE FUSES *K		INPUT CONDUCTORS	
	VOLTS	AMPS	TYPE FN	UL APP'D BUSSMANN	KS-5482-01	KS-20785 *K
208	24	125	30	FRN-R-30	3-#10	2-#10
240	24	125	25	FRN-R-25	3-#10	2-#10
208	48	125	50	FRN-R-50	2-#8, 1-#10	2-#8
240	48	125	50	FRN-R-50	2-#8, 1-#10	2-#8

* KS-20785 COMES WITH A BARE GROUND WIRE.
** TWO PER RECTIFIER OR AN EQUIVALENT CIRCUIT BREAKER.

310. THE ISOLATED CURRENT MEASURING CIRCUIT ON THE 205A1 CONTROL MODULE
CAN BE ADJUSTED IN AN OPERATING RECTIFIER BY FOLLOWING THE
PROCEDURE OUTLINED BELOW:

1. THE "E" TEST POINTS SHALL ALWAYS BE POSITIVE WITH RESPECT TO
EITHER E15 OR E14 TERMINALS FOR ALL VOLTAGE MEASUREMENTS.
2. WITH THE RECTIFIER TURNED ON AND DELIVERING CURRENT, ADJUST
THE OUTPUT VOLTS ADJ POTENTIOMETER SO THAT THE OUTPUT AMMETER
INDICATES ZERO CURRENT.
3. USING A DVM, MEASURE THE VOLTAGE APPEARING BETWEEN TEST POINT
E5 AND E14, THIS VOLTAGE SHALL BE LESS THAN 0.5 VOLTS.
4. CONNECT THE DVM ACROSS E7 AND E15 AND ADJUST POTENTIOMETER R15
SO THAT THIS VOLTAGE IS 2.0 VOLTS. IF THIS ADJUSTMENT IS NOT
POSSIBLE, THEN IT WILL BE NECESSARY TO REPEAT THIS PROCEDURE
STARTING WITH STEP 2.
5. ADJUST THE OUTPUT VOLTS ADJ POTENTIOMETER SO THAT THE RECTIFIER
IS DELIVERING APPROXIMATELY 25% OF RATED CURRENT AS READ ON THE
OUTPUT AMMETER. MEASURE THE MILLIVOLT DROP ACROSS THE SHUNT.
THE AMMETER READING SHOULD BE:
0.625 x SHUNT mV FOR 25A RECTIFIER
1.25 x SHUNT mV FOR 50A RECTIFIER
3.125 x SHUNT mV FOR 125A RECTIFIER
6. BASED ON THE READING OBTAINED IN STEP 7, MEASURE THE VOLTAGE
APPEARING ACROSS E7 AND WITH RESPECT TO E15
THIS VOLTAGE SHALL BE: $V7 = 2V + (V \text{ SHUNT} \times 160)$. THE TABLE
BELOW SHOWS SAMPLE MEASUREMENTS.

SHUNT VOLTAGE MILLIVOLTS	OUTPUT CURRENT			VOLTAGE ACROSS E5 TO E14	VOLTAGE ACROSS E7 TO E15
	25A	50A	125A		
10.0	6.25A	12.5A	31.25	800mV±1%	3.60V±1%
20.0	12.5A	25A	62.5	1.60V±1%	5.20V±1%
30.0	18.75A	37.5A	93.75	2.40V±1%	6.80V±1%
40.0	25A	50A	125	3.20V±1%	8.40V±1%

NOTES:

1. THE FOLLOWING EQUIPMENT IS NEEDED TO PERFORM THE
TESTS SHOWN ABOVE:
(a) DIGITAL METER KS-22861, L1
(b) TRIMPOT SCREWDRIVER
2. THE VOLTAGE APPEARING ACROSS E5 TO E14 IS 80 TIMES
THE MILLIVOLT READING OBTAINED ACROSS THE SHUNT, ±1%.

INFORMATION NOTES: (CONT)

311. OPERATION AND MAINTENANCE AT&T-790-106.

312. THE CHASSIS OF THE RECTIFIER SHALL BE GROUNDED PER
REQUIREMENTS OF AT&T-802-001-180.

313. PROVIDE A NO. 6 AWG KS-5482-01 FRAME GROUNDING CONDUCTOR
FROM THE BAY FRAMEWORK THAT MOUNTS THE RECTIFIER TO THE CO.
GRD SYSTEM IN ACCORDANCE WITH FRAME GROUNDING REQUIREMENTS
PER AT&T-802-001-180. WHEN THE CO. GRD SYSTEM IS NOT
INSTALLED IN THE OFFICE AND THE RECTIFIER IS ASSOCIATED
WITH:

- A. AN ESS, DEDICATED POWER PLANT HAVING AN INSULATED
DISCHARGE GROUND BUS. THE CONDUCTOR SHALL BE
CONNECTED TO THE GROUND WINDOW, IF NEARER, OR TO
THE SAME GROUND POINT (IE WATER PIPE) THAT THE ESS
GROUND WINDOW BUS IS GROUNDED TO, OR.
- B. A NON-ESS POWER PLANT, CONDUCTOR SHALL BE CONNECTED
TO THE POWER PLANT DISCHARGE GROUND BUS.

WHEN MORE THAN ONE RECTIFIER BAY REQUIRES GROUNDING, A
SINGLE CONDUCTOR MAY BE MULTIPLIED TO GROUND ALL RECTIFIER
BAYS.

314. AC EQUIPMENT GROUND CONDUCTOR SHALL BE PROVIDED AS SPECIFIED
IN AT&T-802-001-180.

315. EARLY PRODUCTION MAY USE 1N-2057, 1N4047 OR 1N2066.

316. EARLY PRODUCTION MAY USE 85HF20 (CR3) AND 85HF20 (CR4)
OR 72HF20 (CR3) AND 72HF20 (CR4).

317. FOR J85502C, LC RECTIFIER, OPTION ~~(W)~~ **(W)**, THE OUTPUT FILTER
CAPACITORS ARE INDIVIDUALLY FUSED TO PROVIDE AN ALARM
AS DOCUMENTED ON SHEET B3. ALSO, INDIVIDUAL RESISTORS
ARE USED TO DISCHARGE EACH CAPACITOR. OPTION ~~(W)~~ **(W)** APPLIES
TO 48 VOLT OUTPUT RECTIFIER (OPTION W) ONLY.

FOR J85502C, LC RECTIFIER APPLICATIONS, OPTION ~~(W)~~ **(W)**, THE
RECTIFIER IS FURNISHED WITH AUXILIARY TERMINALS (FROM
E16 AND E17 OF THE 205A1 BOARD) TO GAIN ACCESS TO THE
EQUALIZE FEATURE MANUALLY AND A TERMINAL STRIP TO
PROVIDE LOCAL ACCESS TO THE CONTROL AND ALARM FUNCTIONS
OF THE RECTIFIER.

318. FOR J85502C, LC RECTIFIER APPLICATIONS FOR GTE, THE
OUTPUT VOLTAGE OF THE RECTIFIER IS SET TO FLOAT THE
BATTERIES AT 52.08 VOLTS AT NO LOAD WITH THE RECTIFIER
AND THE EXTERNAL SENSED LEADS CONNECTED TO THE BATTERY.

319. REMOVE STRAPS OR RESISTORS ON ED83158-30 GROUP 3 (CMI OPTION BOARD)
PER THE FOLLOWING TABLE:

ED83158-30 GROUP 3 (CMI) BOARD OPTIONS			
OPTION	KEEP straps or resistors marked with	REMOVE straps or resistors marked with	
125-Ampere Output (J85502C-1)	F	N,K	
24 VDC Output	V	W	
48 VDC Output	W	V	
External HV Shutdown Signal	Available, 24V or 48V	M, ZJ (see note 1)	Q,T, & "Q,T" (see note 1)
	Not Available, 24V	Q, ZJ (see note 1)	T,M (see note 1)
External Sensing Leads	Not Available, 48V	T, ZJ (see note 1)	Q,M
	Available	ZA, ZJ (see note 1)	-
		ZJ (see note 1)	ZA
Note 1: Option Q,T, (not "Q,T") and ZJ are movable straps. To remove the option, move the strap to "CHG" position.			
Note 2: To initial charge batteries, move straps to "CHG" positions as shown below. When completed, restore the options to the proper positions listed above.			
Initial Battery Charging	E/W 205A1 or 205B	Q,T (not "Q,T") in "CHG" pos; ZJ in "NORM" pos.	
	E/W 205A	Q,T (not "Q,T"); ZJ in "CHG" pos.	

Copyright © 1982 AT&T
All Rights Reserved

"LINEAGE" 2000 RECTIFIER CIRCUIT
J85502C

OWB SIZE 63	ISSUE 9AC
----------------	--------------

AT&T SD-82659-01 SHEET D2


THE FOLLOWING TABLE DOCUMENTS THE CONNECTIONS REQUIRED FROM P2A OF THE CM2 CIRCUIT PACK OF J85502 RECTIFIERS TO SELECTED CONTROL UNITS.

TABLE A

RECTIFIER CM2 CARD	CONTROL UNITS				
	MCS LINEAGE J85501A	CONVENTIONAL LINEAGE AND J85516 A,B,C	111A PLANT	326 PLANT	XCS LINEAGE J85501B
1	CB	CB	NFA	RFA	CB
2 NOTE 1	RG(RB)	RG(RB)	RG(RC)	RG(RB)	RG(RB)
3	CBR	CBR	(PLANT)GRD	(PLANT)GRD	CBR
4	TRH				
5	BAT	BAT	CBS	CONT	BAT
6	DPG	LOAR			LOAR
7	TP0				
8	TP1				
9	TP2				
10	EQ24				
11					
12	PH	LOA			LOA
13		STRAP TO 14	STRAP TO 14	STRAP TO 14	STRAP TO 14
14		STRAP TO 13	STRAP TO 13	STRAP TO 13	STRAP TO 13
15	RFA	RFA			RFA
16	RFA	RFA			RFA
17		PMN	RFA	RFA	
18		PMNR	(PLANT)GRD	(PLANT)GRD	
19		PMNV			
20		PMNVR			
21	EQ48				
22	STRAP TO 28	STRAP TO 28	STRAP TO 28	STRAP TO 28	STRAP TO 28
23		GRD			
24	VI				
25	MAN				
26	TP3				
27 NOTE 1	RB(RG)	RB(RG)	RC(RG)	RB(RG)	RB(RG)
28	STRAP TO 22	STRAP TO 22	STRAP TO 22	STRAP TO 22	STRAP TO 22
29					
30					
31	APG				
32		HVR			
33		TRR			TRR
34 NOTE 305	RS	RS		RS	RS
35	VP				
36 (24V PLANT)	HV24	HV24	HV24	HV24	HV24
37 NOTE 305	RSR	RSR		RSR	RSR
38 (48V PLANT)	HV48	HV48	HV48	HV48	HV48
39 (48V PLANT)	TR48	TR48	TR48	TR48	TR48
40 (24V PLANT)	TR24	TR24	TR24	TR24	TR24

NOTE: 1. THE R-LEAD, PIN 2 OF P2A, MUST BE CONNECTED TO A NEGATIVE VOLTAGE FROM THE POINT OF REGULATION. THE R+LEAD, PIN 27 OF P2A, MUST BE CONNECTED TO A POSITIVE VOLTAGE FROM THE POINT OF REGULATION. THE PLANT LEAD DESIGNATIONS SHOWN WITHOUT BRACKETS ARE FOR A POSITIVE PLANT (NEGATIVE GROUND). THE PLANT LEAD DESIGNATIONS SHOWN IN BRACKETS ARE FOR A NEGATIVE PLANT (POSITIVE GROUND).


CAD 1
POWER PLANT CONNECTIONS
SEE NOTE 307, 309, 310

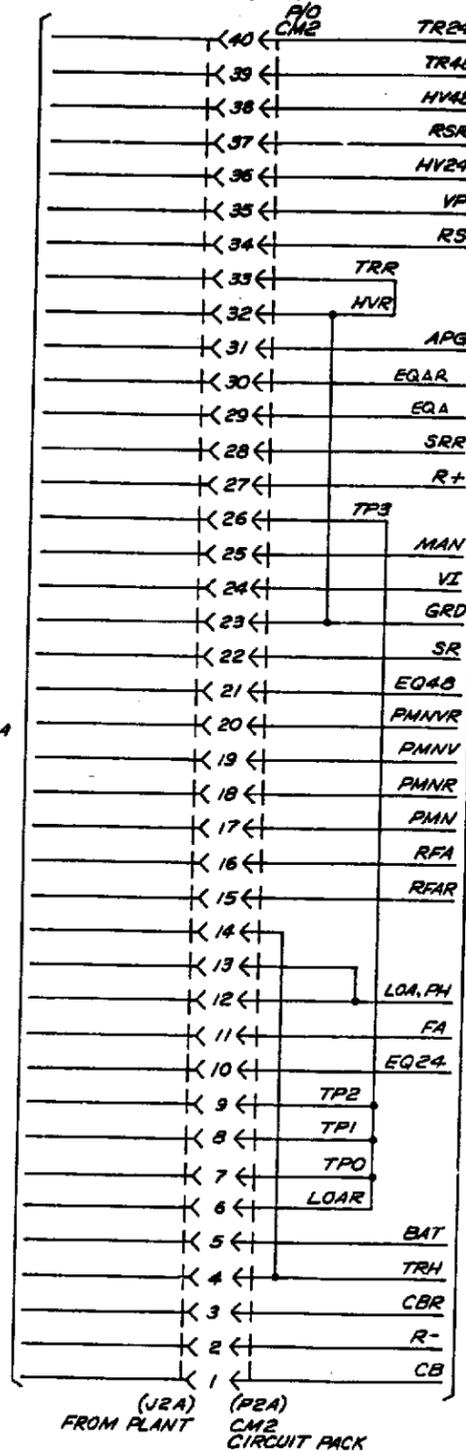


SEE TABLE A

(J2A) FROM PLANT
(P2A) CM2 CIRCUIT PACK


CAD 2

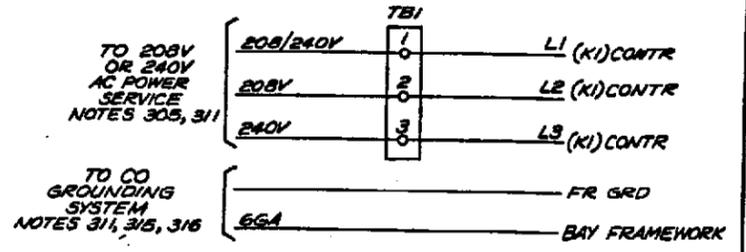


CAD 3

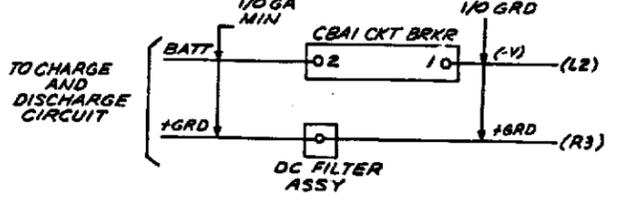

CAD 4

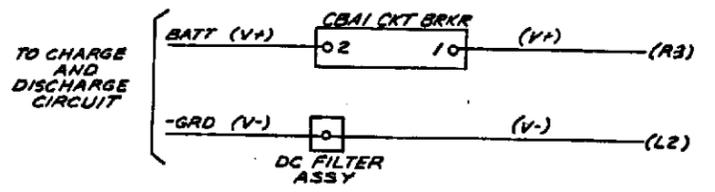

CAD 5

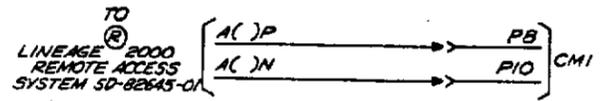

Copyright © 1982 AT&T
All Rights Reserved

"LINEAGE"® 2000 RECTIFIER CIRCUIT
J85502C

DWG SIZE	ISSUE
65	5B

AT&T SD-82659-01 SHEET GI